


T. 40 S., R. 3 W., W. M.

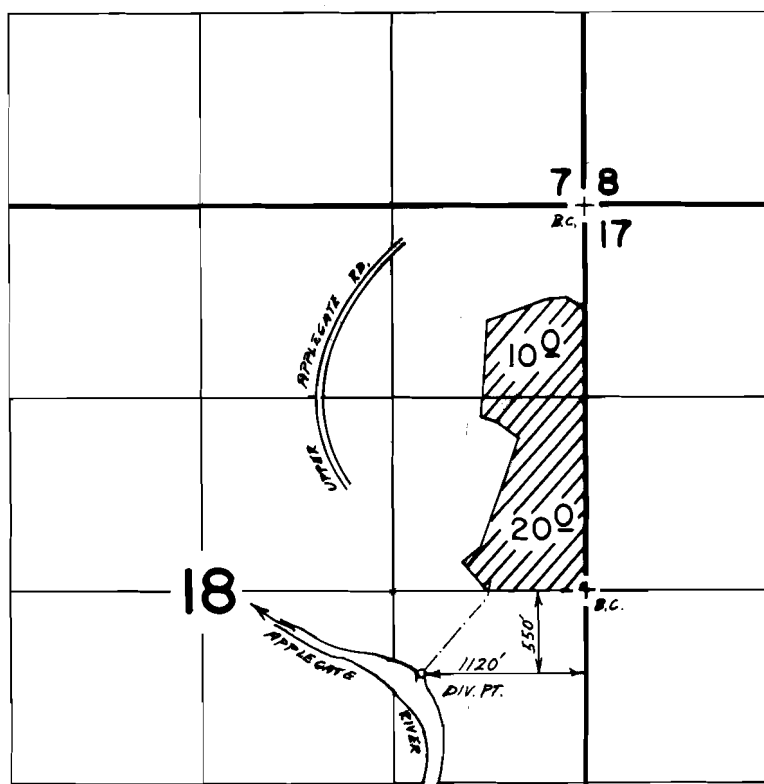

Scale 1" = 1320'

FINAL PROOF SURVEY
UNDER

Application No. 55972... Permit No. 42215...
IN NAME OF

.....MORRIS BYRNE.....

Surveyed August 21 1986, by B.S. JAMES.....