


T.5S.,R.1W.,W.M.

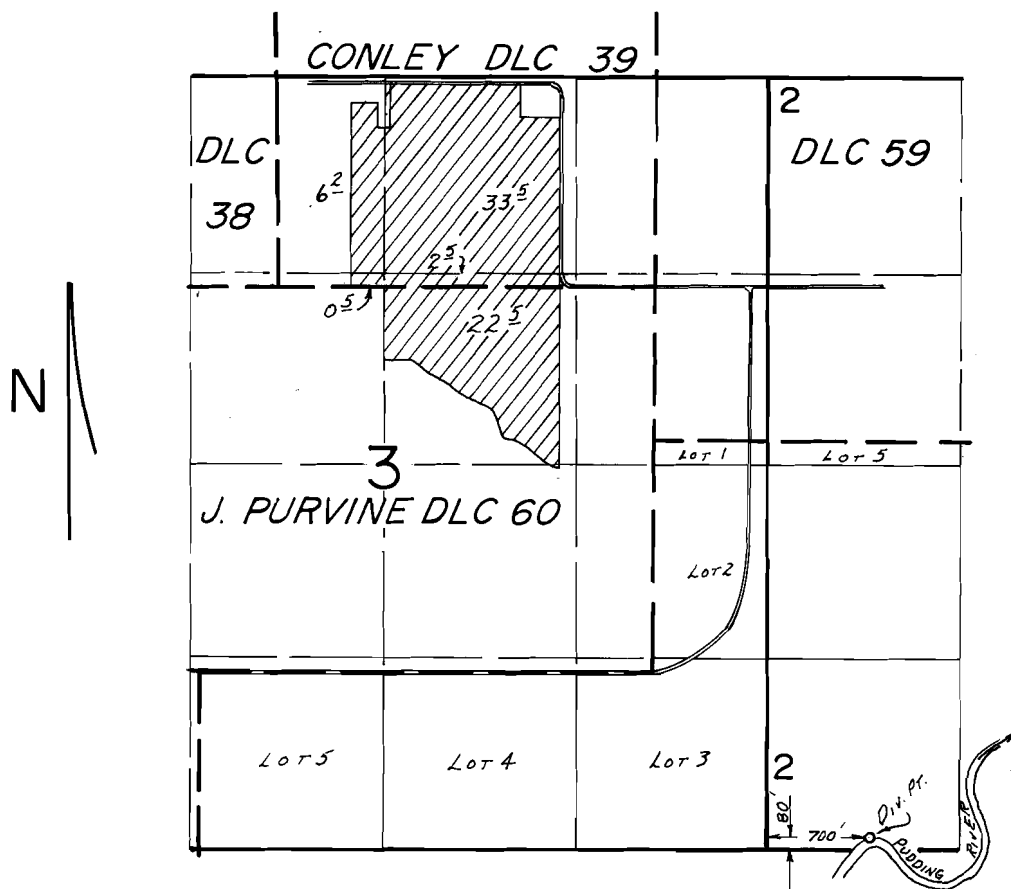

SCALE: 1" = 1320'

FINAL PROOF SURVEY
UNDER

Application No. 55915.... Permit No. 42234.....
IN NAME OF

.....MANTON A. CARL.....

Surveyed May..10.... 1984., by B.W. BISHOP.....