
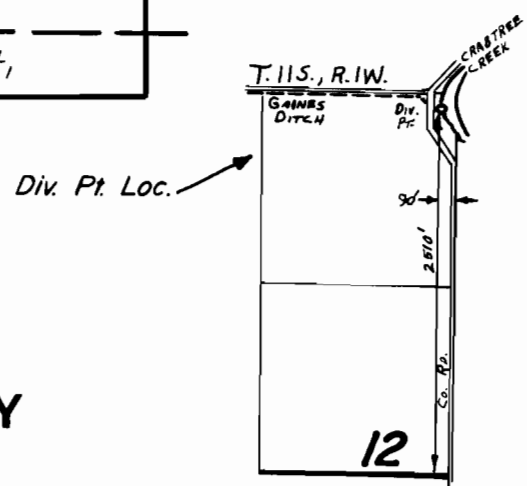
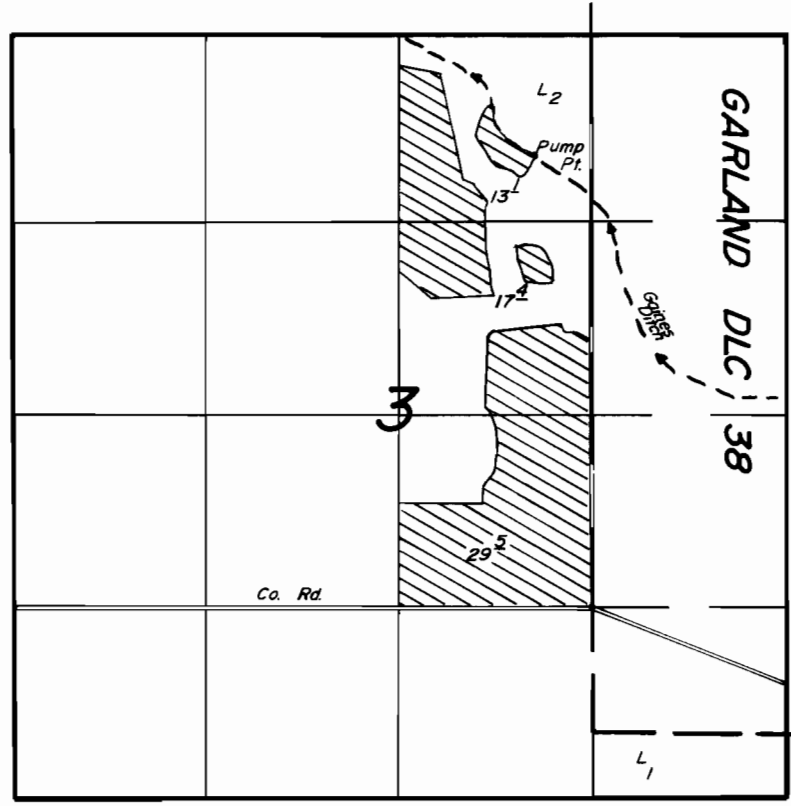


T.11S., R.1W., W.M.

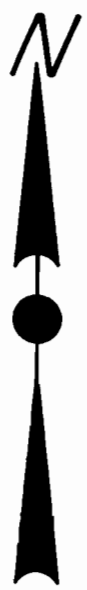

Scale: 1" = 1320'
FINAL PROOF SURVEY
 UNDER

Application No. 56146 Permit No. 42239
 IN NAME OF

TONY & JACQUELINE GODINHO

Surveyed Oct. 14, 1983, by M. Cahill
 & June 5, 1984, by L. Toll