


T. 4 S., R. 4 W., W.M.

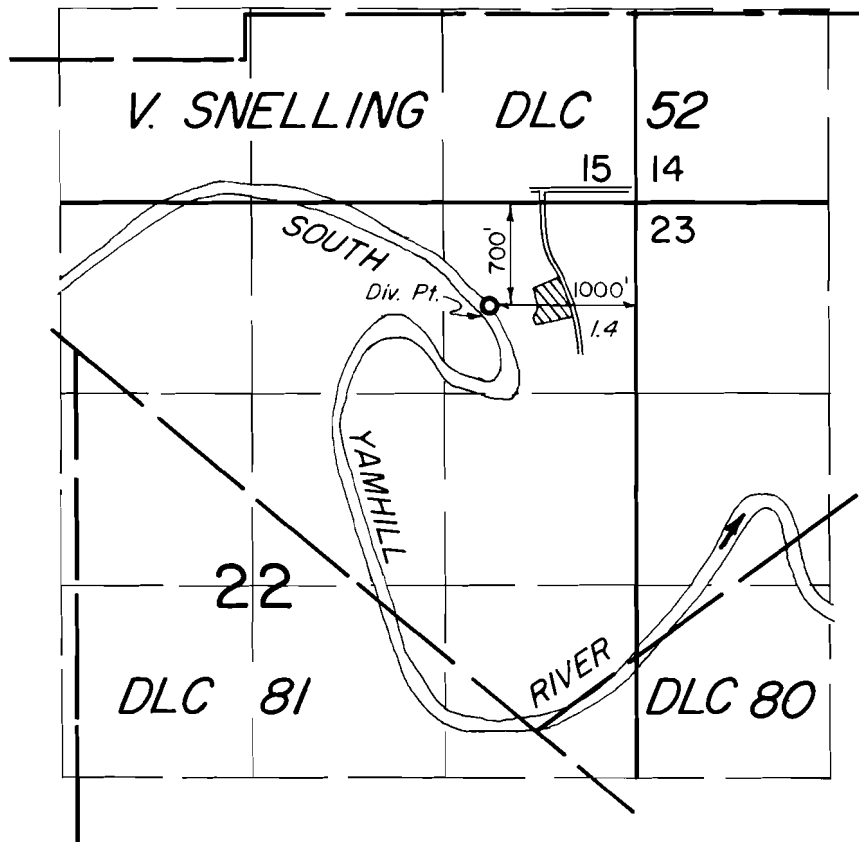

FINAL PROOF SURVEY UNDER

Application No. 56367 Permit No. 42312.....
IN NAME OF

W. E. & I.D. McGANTY

Surveyed MAY 8., 1979, by [Signature].....