


T.11S.,R.2W.,W.M.

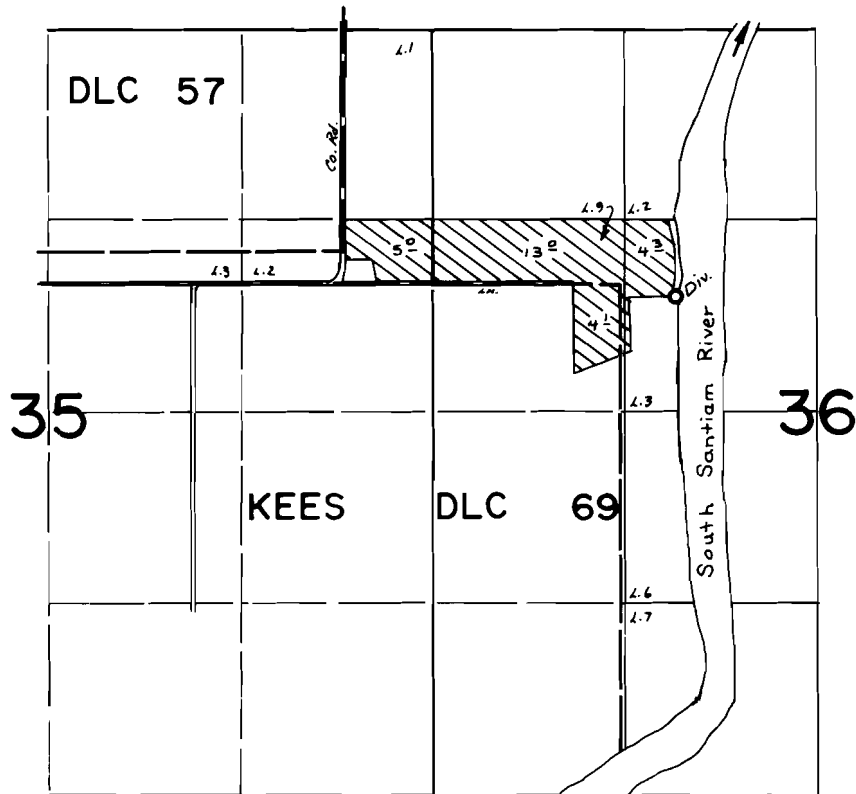

Div. Pt. Loc: 80 ft. S. and 380 ft. E. from the NE Cor. Kees DLC 69

FINAL PROOF SURVEY
UNDER

Application No. 54440 Permit No. 42403
IN NAME OF

FRANK RAUSCHKOLB

Surveyed Aug. 6, 1981, by L. TOLL