


T.16S.,R.2E.,W.M.

SECTION 33

SW 1/4 NW 1/4

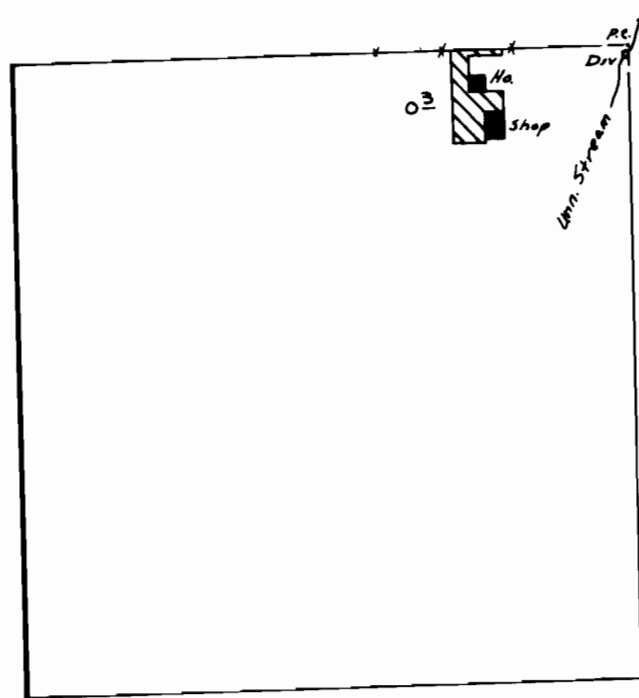

Div. Loc: 20 ft. S and 5 ft. W from NE Cor SW 1/4 NW 1/4 Sec 33

SCALE: 1" = 400'

FINAL PROOF SURVEY
UNDER

Application No. 56646.. Permit No. 42405.....
IN NAME OF

MELVIN P. OTTERSON.....

Surveyed Aug. 20... 1981..., by S.C. BROWN.....