


Application No. 9517

Permit No. 6310

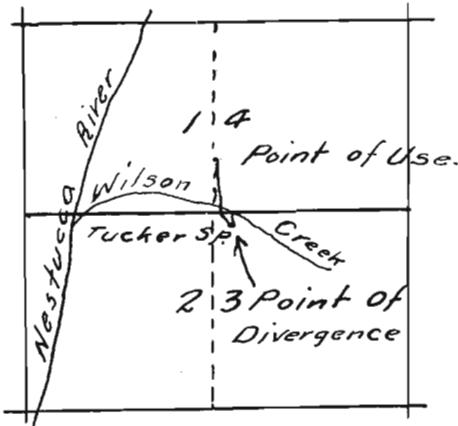

Map

to accompany application of J. L. George
for permit to appropriate water.

Point of Divergence
 $558^{\circ} 03'E$ 208.4'

Point of Use
 $N1^{\circ} 30'W.$ 860.1'

1/4 corner common to
sections 14 and 23
T. 4 S. R. 10 W. N.M.

STATE ENGINEER
RECEIVED

MAY 31 1924

SALEM OREGON

I G.S. Gray of Cloverdale, Ore. do
hereby certify that this map was made
by me on Oct. 15, 1923, and that it correctly
represents the works described in the
accompanying application together with
the location of streams and other ditches
in the immediate vicinity

J. S. Gray Reg. Eng. # 1196