


T.8S. R.6W. W.M.

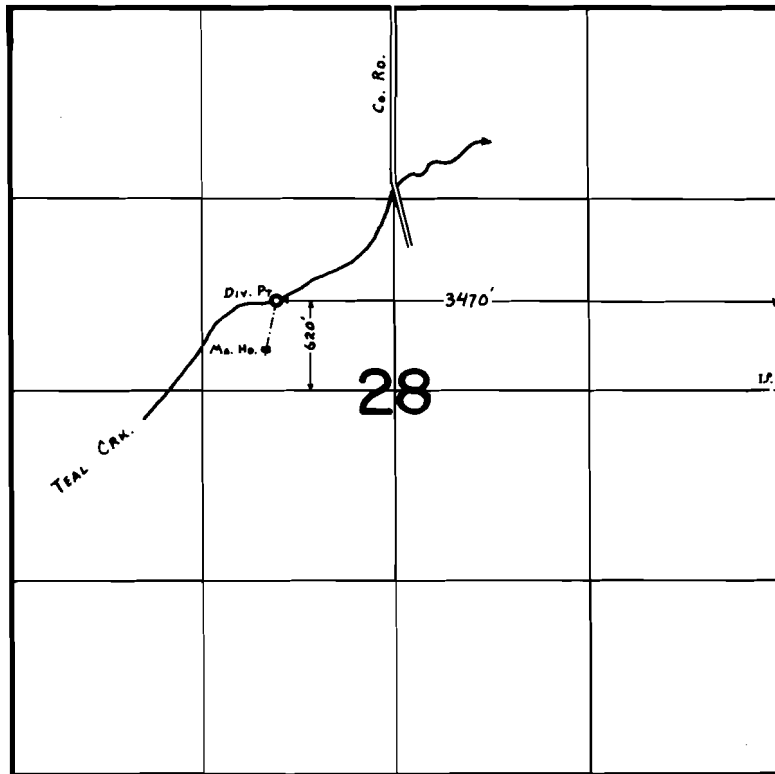

FINAL PROOF SURVEY
UNDER

Application No. ~~56525~~ Permit No. 42410.....
IN NAME OF

PETER W. RONZAND

Surveyed July 18, 1979, by C. L. HUGHES.....