


# T.13S.,R.31E.,W.M.

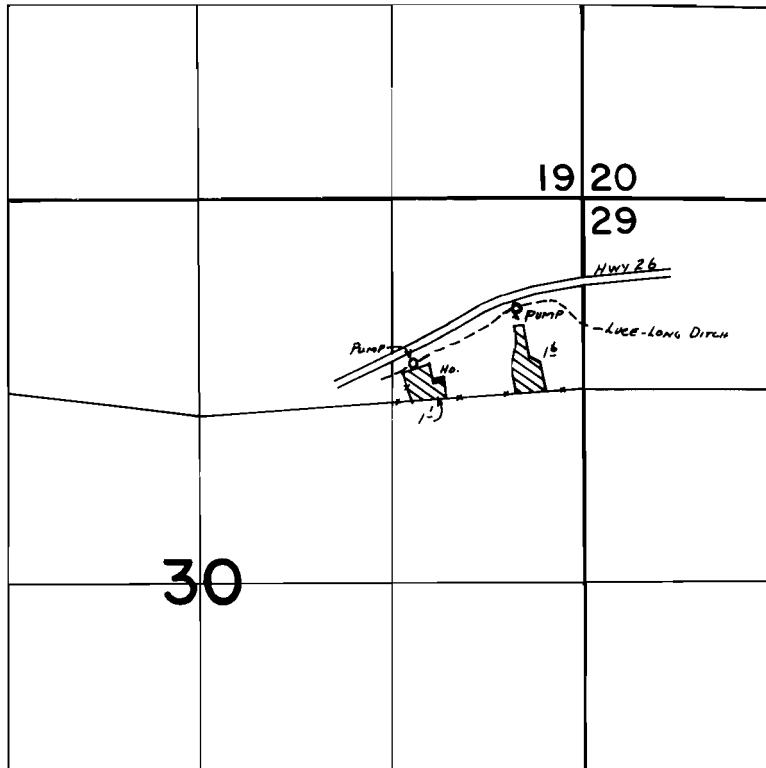

DIV. PT. FROM JOHN DAY RIVER LOC: 1000 ft. N. AND 10 ft. E. FROM S<sup>1</sup>/<sub>4</sub> COR. SEC. 22  
T.13S., R.31E., W.M. (SHOWN ON FINAL PROOF MAP FOR CERTIFICATE 35330)

## FINAL PROOF SURVEY UNDER

Application No. .56485. Permit No. .42419.....  
IN NAME OF

.....**DARWIN ARNELL**.....

Surveyed .Sept..29. 1981., by .S..G..BROWN.....