


T. 18S., R. 8W., W. M.

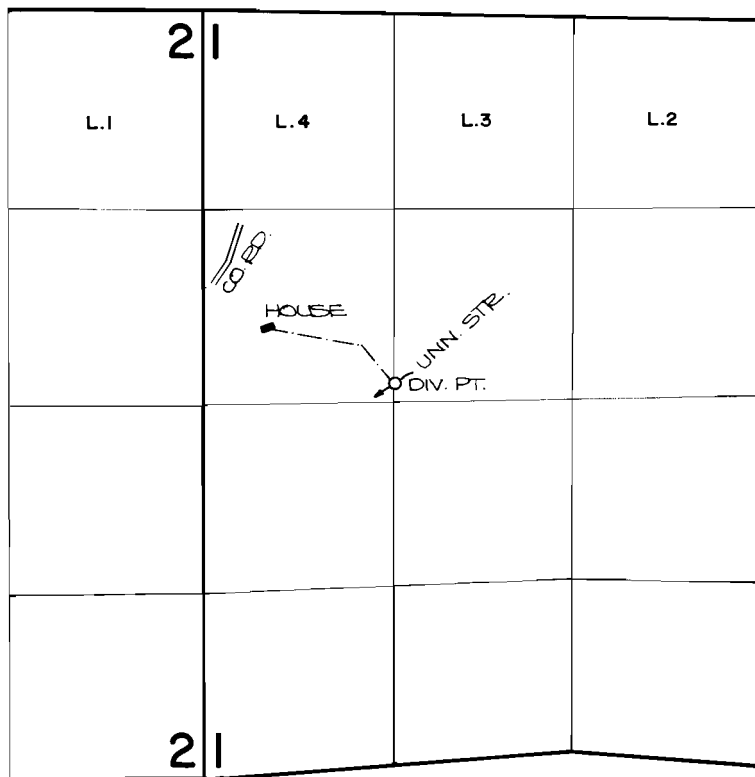

DIV. PT. LOCATION: 120 FT N. FROM THE S.E. CORNER
OF THE S.W. 1/4 OF THE N.W. 1/4

FINAL PROOF SURVEY UNDER

Application No. 57483 Permit No. 43604
IN NAME OF

SUSANNA FARKAC DEFAZIO

Surveyed JUNE 26, 1984, by P. P. Patten



SCALE: 4" = 1 MILE