


T.9S.,R.4E.,W.M.

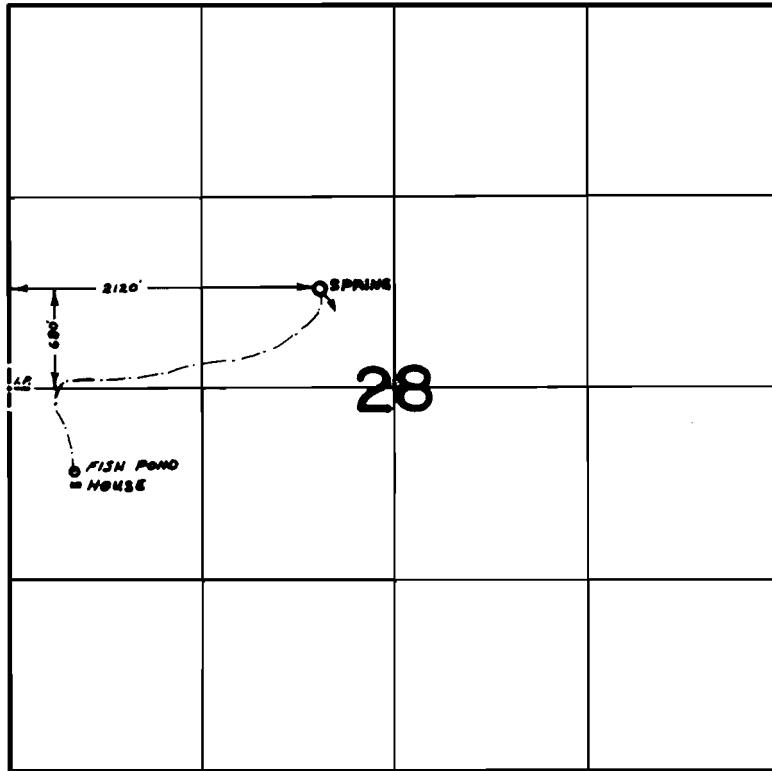

**FINAL PROOF SURVEY**  
UNDER

Application No. 57914 Permit No. 43645.....  
IN NAME OF

.....HENRY H. HIEBERT.....

Surveyed Aug. 10, 1981, by L. TOLL.....