
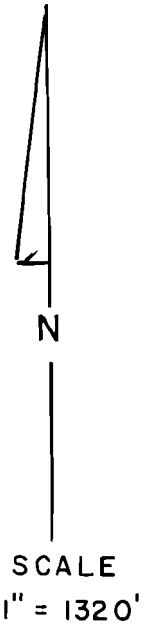


T. 4 S., R. 10 W., W.M.

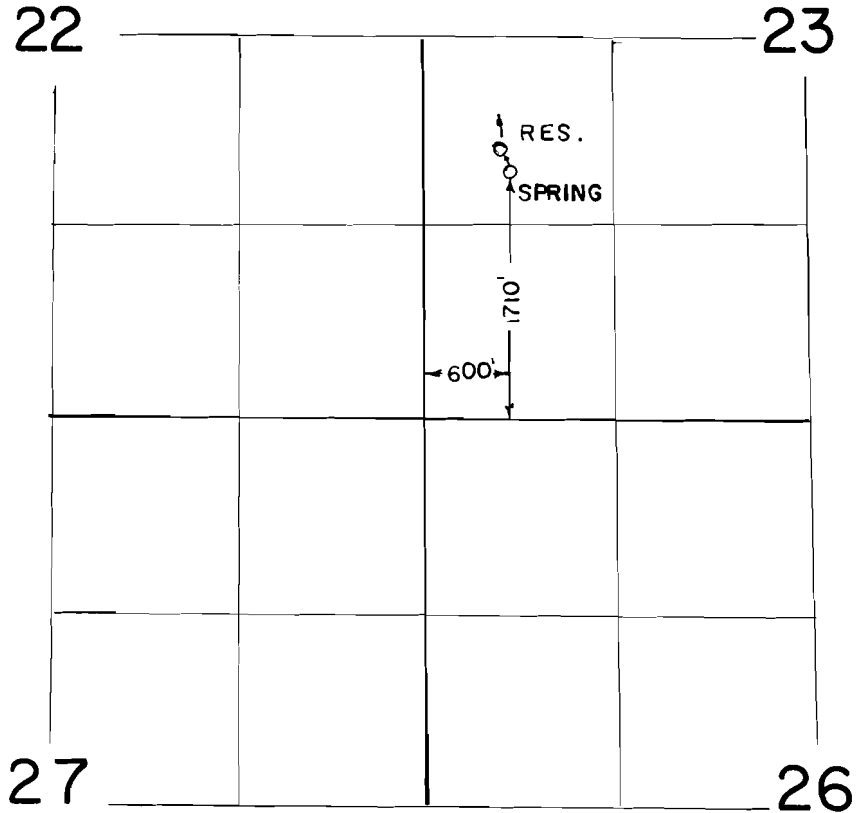

FINAL PROOF SURVEY
UNDER

R 60885 R 8328

Application No. 60705 Permit No. 46171
IN NAME OF

MERT LOUCKS

Surveyed AUG 2 1984, by P. PAGTER