


T. 37 S., R. 6 W., W. M.

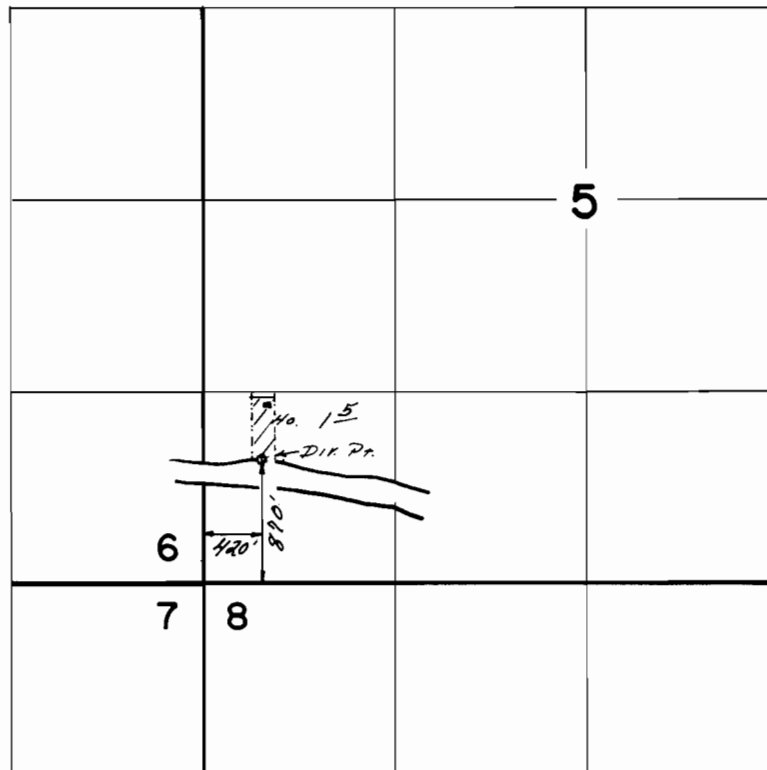

Scale: 1" = 1320'

### FINAL PROOF SURVEY

UNDER

Application No. **63250** Permit No. **46709**  
**65824** **48024**

IN NAME OF

**JOSEPH J. ORRIO**

Surveyed JUL 31 1986, by B. S. JAMES.