


T. 37 S., R. 6 W., W. M.

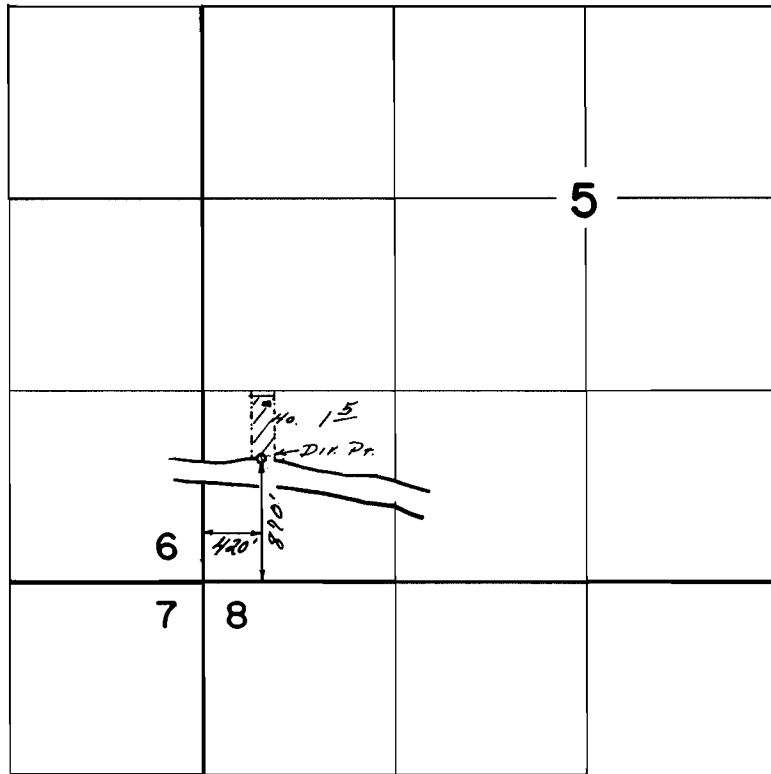

Scale: 1" = 1320'

**FINAL PROOF SURVEY**  
UNDER

63250                      46709  
Application No. **65824** Permit No. **48024**...  
IN NAME OF

..... **JOSEPH J. ORRIO** .....

Surveyed JUL...31... 1986, by B....S....JAMES.