


T.38S. R.4W. W.M.

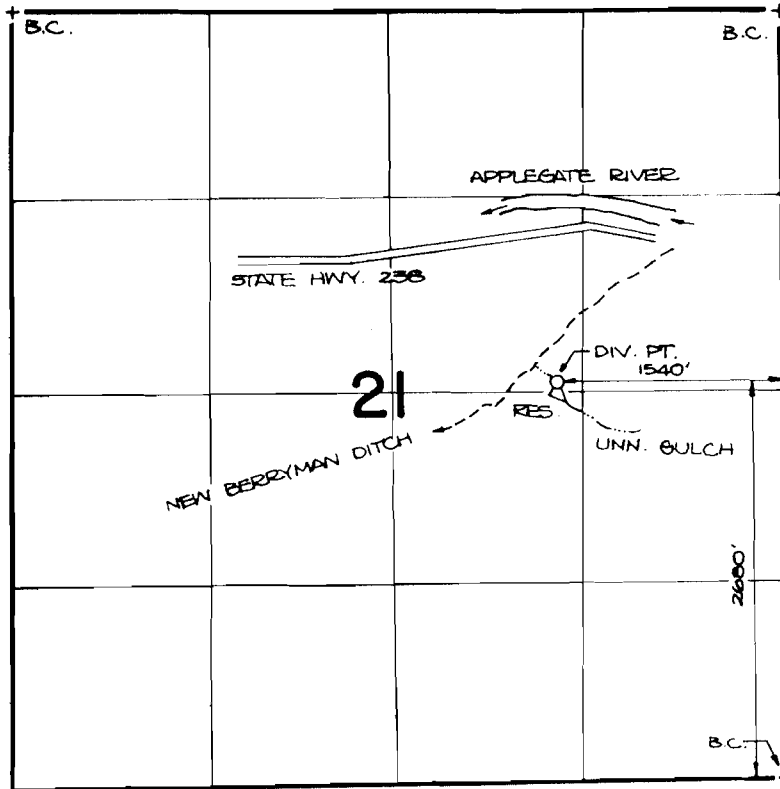

FINAL PROOF SURVEY UNDER

R-61828 R-8519
Application No. 62412 Permit No. 47093
IN NAME OF

C. LOREN BOWMAN

Surveyed JULY 27, 1983, by B. JAMES