


T. 28S., R. 6 W., W.M. SECTION 32

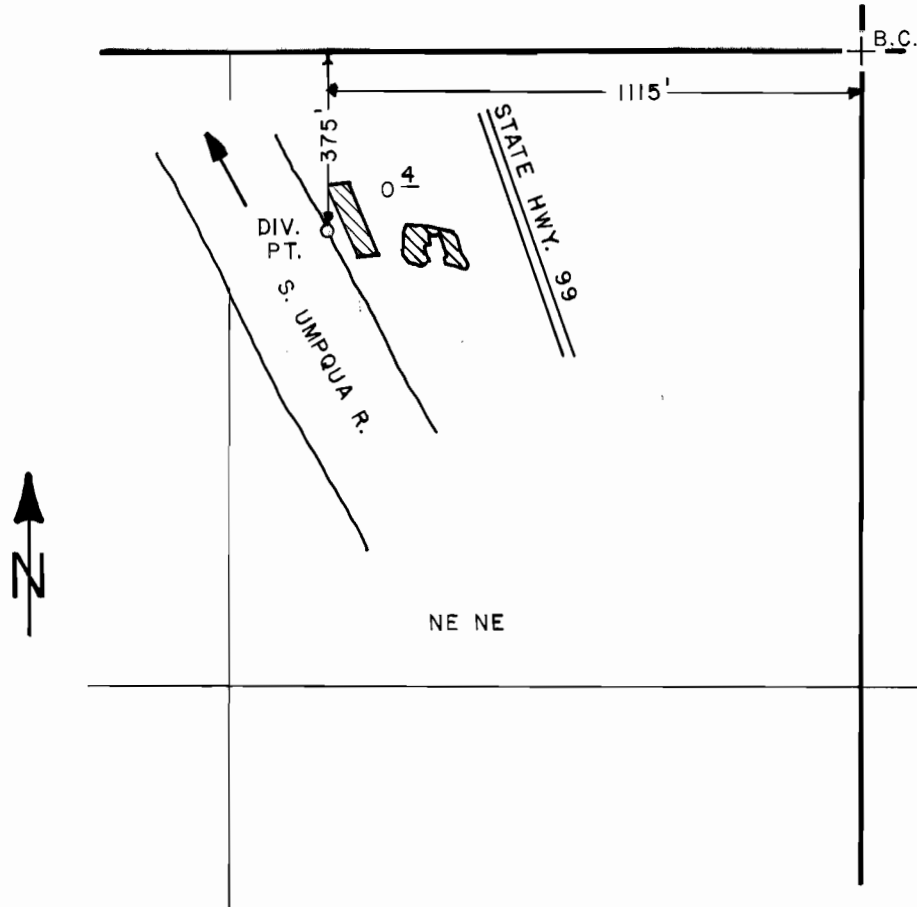

SCALE: 1" = 400'

FINAL PROOF SURVEY UNDER

Application No. 65986 Permit No. 48038
IN NAME OF

THE ESTATE OF MORRIS R. CHERRICK

JAN. 7 88 J.M. SCHMORDE
Surveyed JUNE 17 1986, by J.R. KAUPPILA