


UNITED STATES
DEPARTMENT OF THE INTERIOR
BUREAU OF LAND MANAGEMENT

SECTION
26
SE⁴ NE⁴

Oregon State Water Filings

TOWNSHIP 22 S., RANGE 38 E., W. M.

North

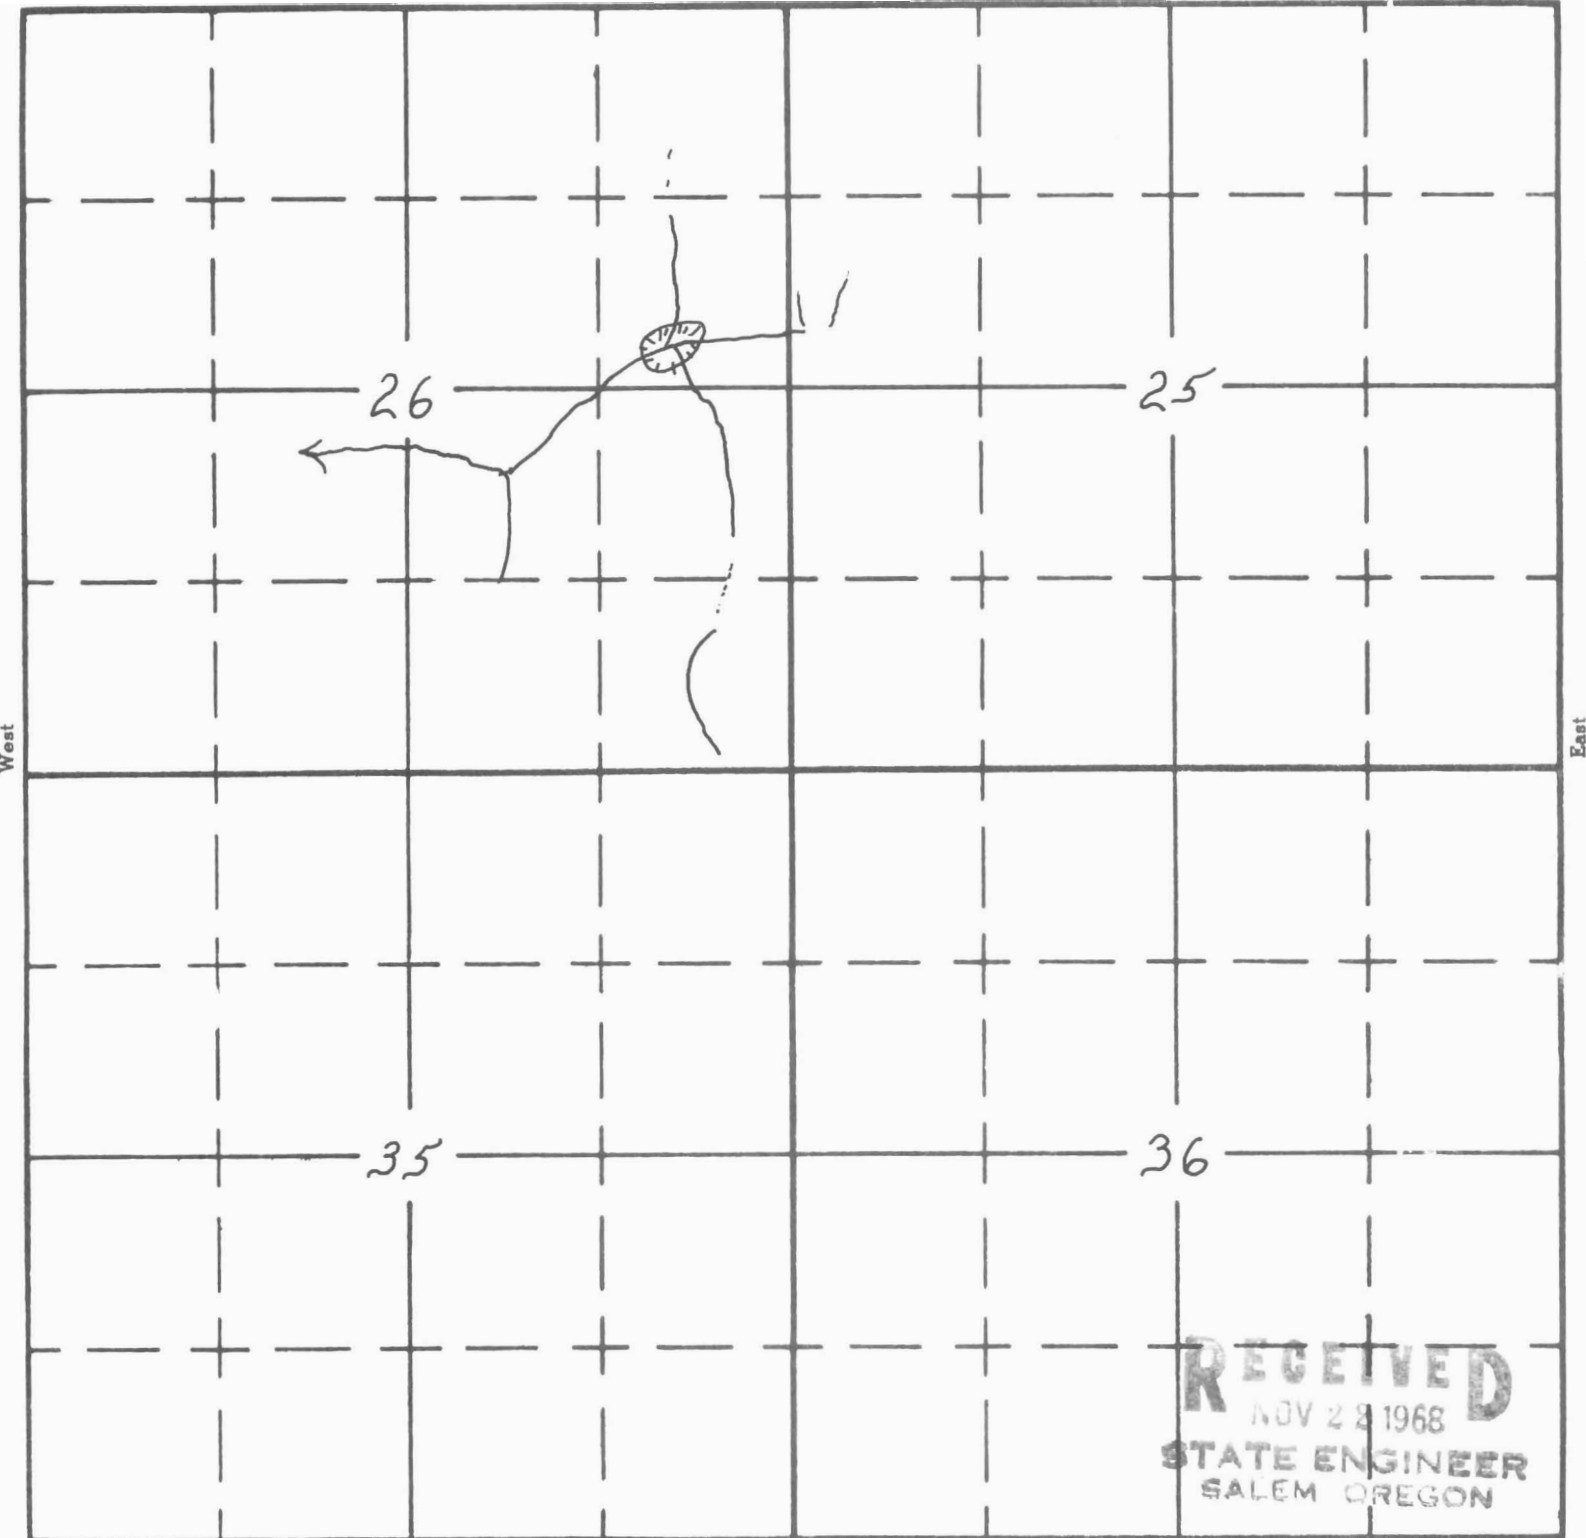

South

Basque Pit

APPLICATION No. 7400
PERMIT No. 7400