


UNITED STATES
DEPARTMENT OF THE INTERIOR
BUREAU OF LAND MANAGEMENT

SECTION
NE 1/4 SW 1/4
Sec
8

Oregon State Water Filings

TOWNSHIP 15 S, RANGE 43 E, W. M.

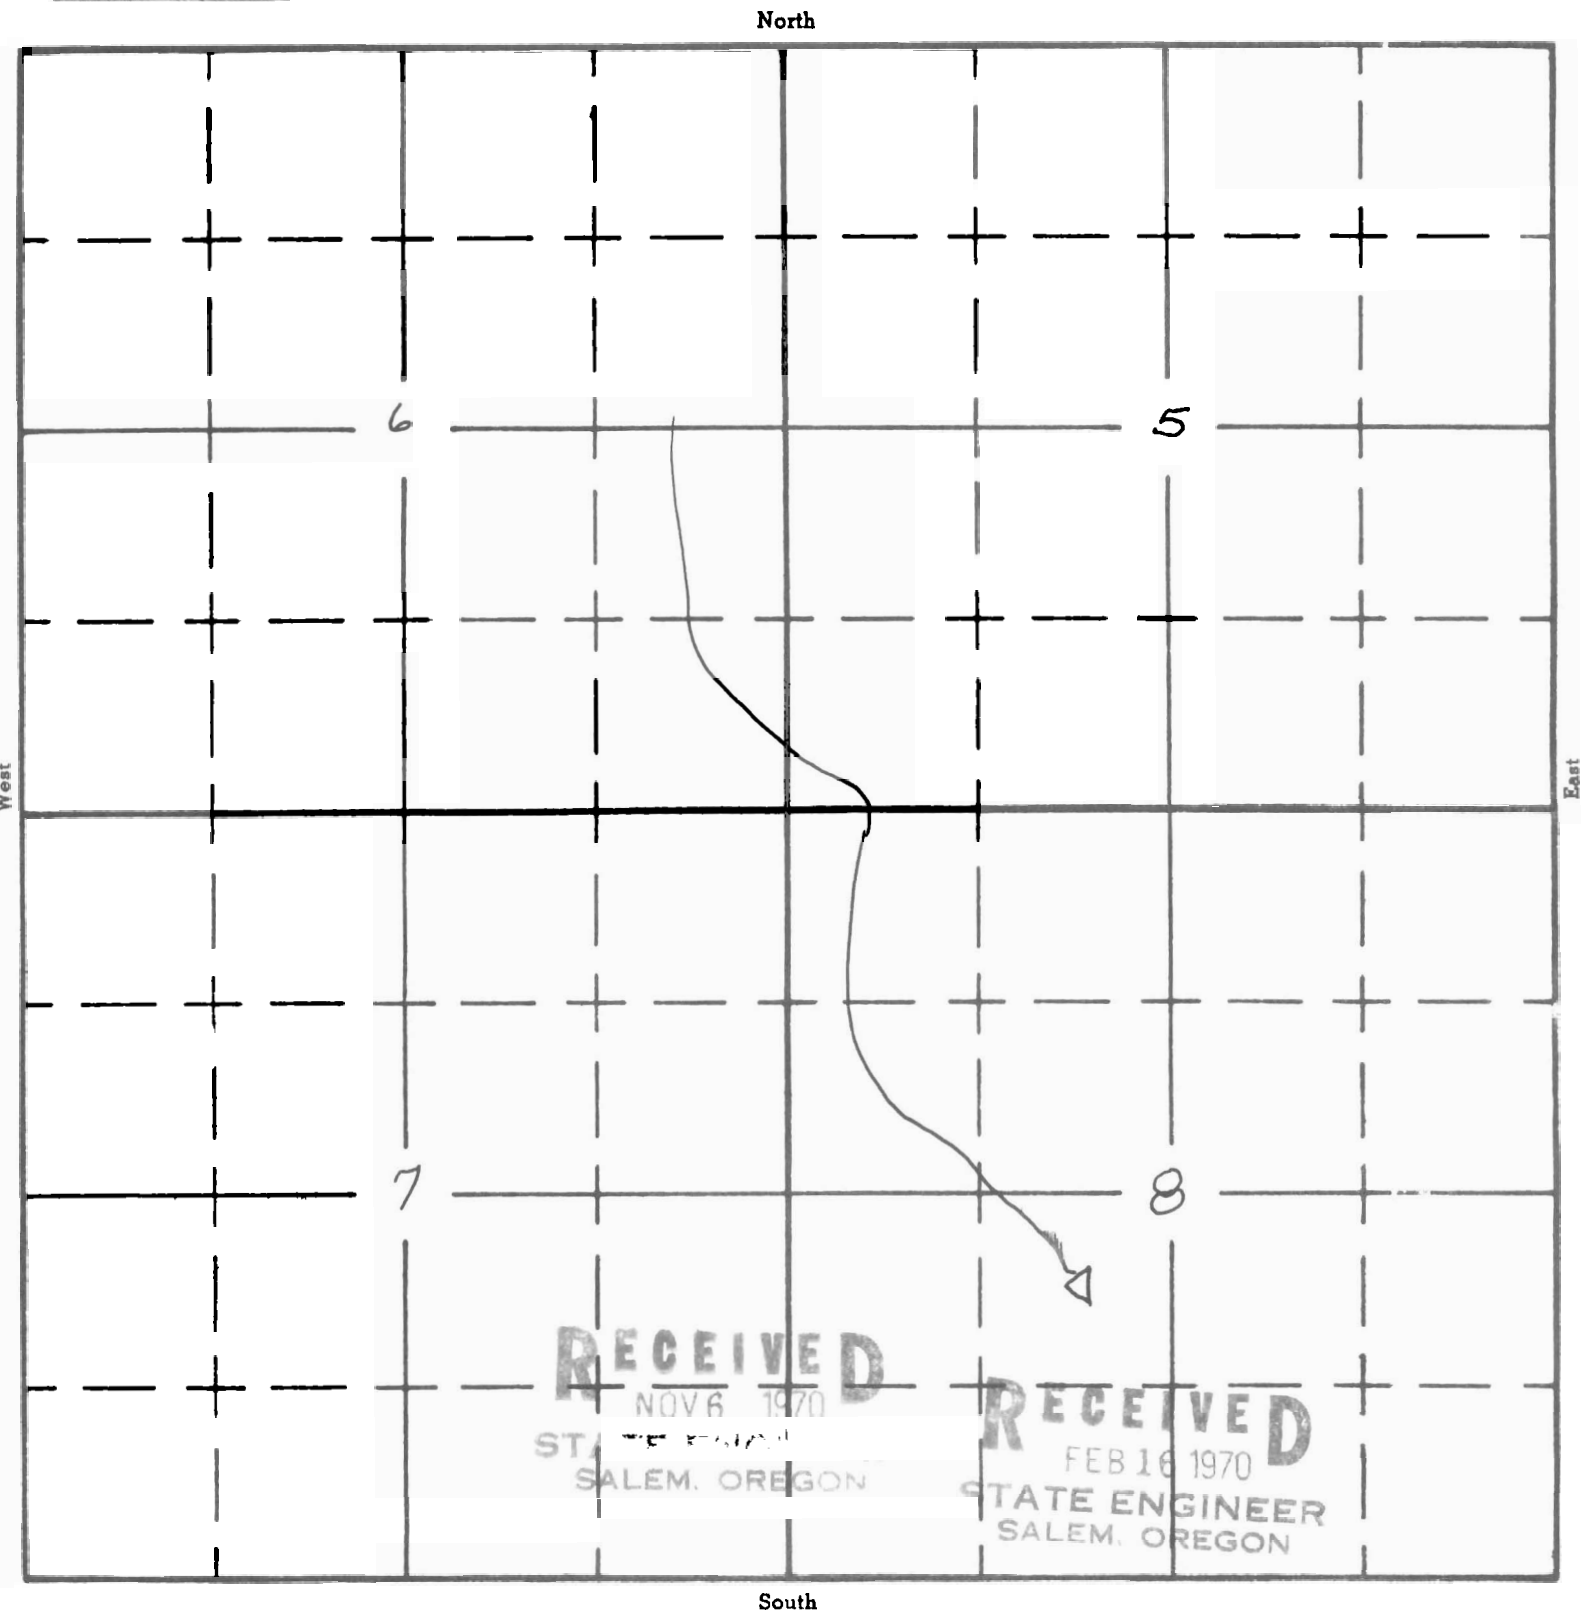

Winebarger.

APPLICATION No. 1171
PERMIT No. 1171