

UNITED STATES
DEPARTMENT OF THE INTERIOR
BUREAU OF LAND MANAGEMENT


SECTION

Oregon State Water Filings

NW 1/4 NE 1/4
Sec 24

TOWNSHIP 21^S, RANGE 42^E, W. M.

North

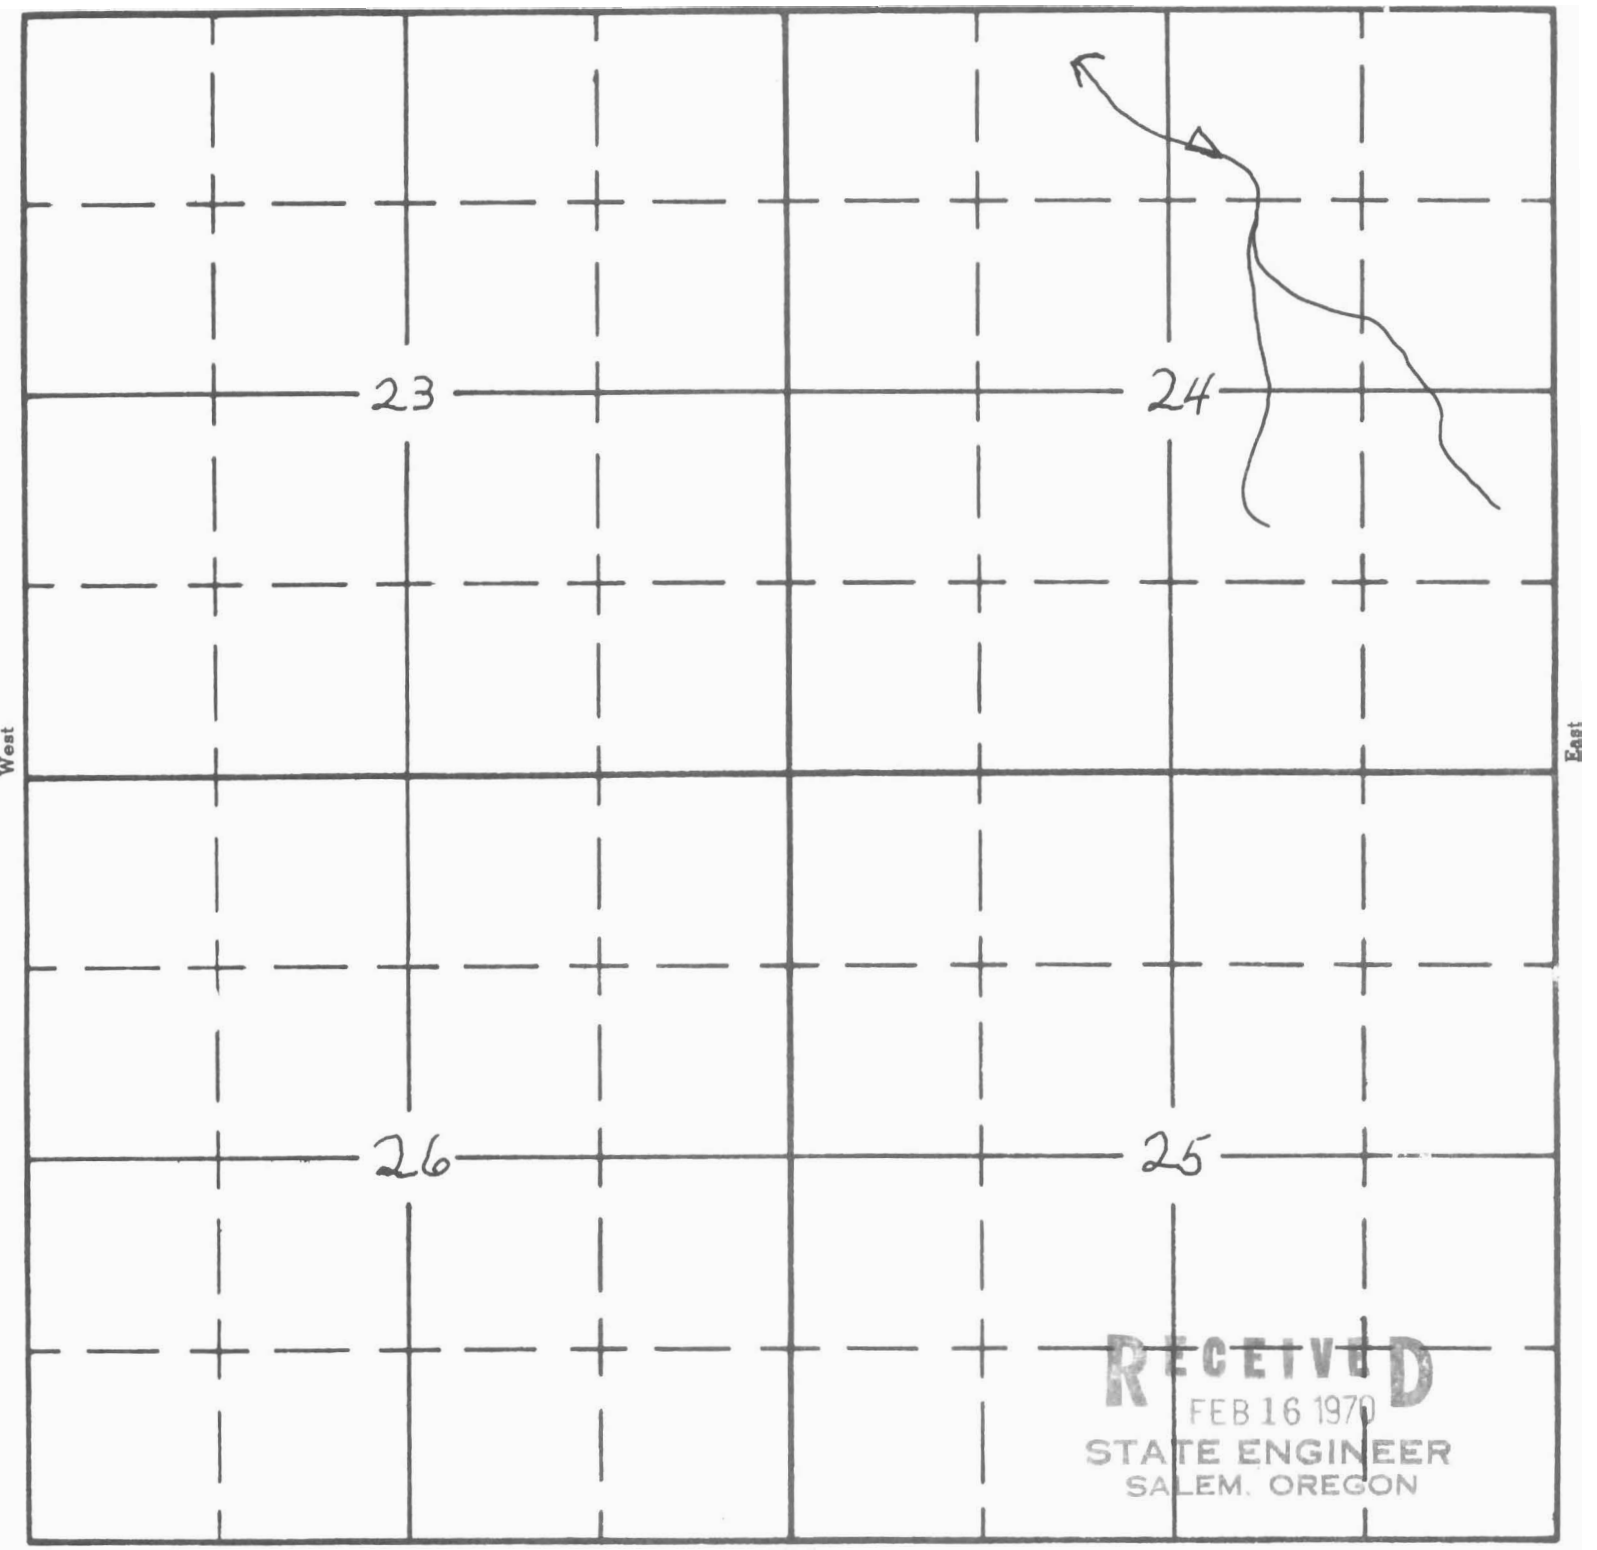

RECEIVED
FEB 16 1970
STATE ENGINEER
SALEM, OREGON

South

H09 be9

APPLICATION No. 1000
PERMIT No. 2000