

Form AI-187
March 1961

UNITED STATES
DEPARTMENT OF THE INTERIOR
BUREAU OF LAND MANAGEMENT

SECTION 24

Oregon State Water Filings


HOFFER

SE 1/4 SW 1/4

TOWNSHIP 19S, RANGE 38E, W. M.

SCALE 8" = 1 MI.

North

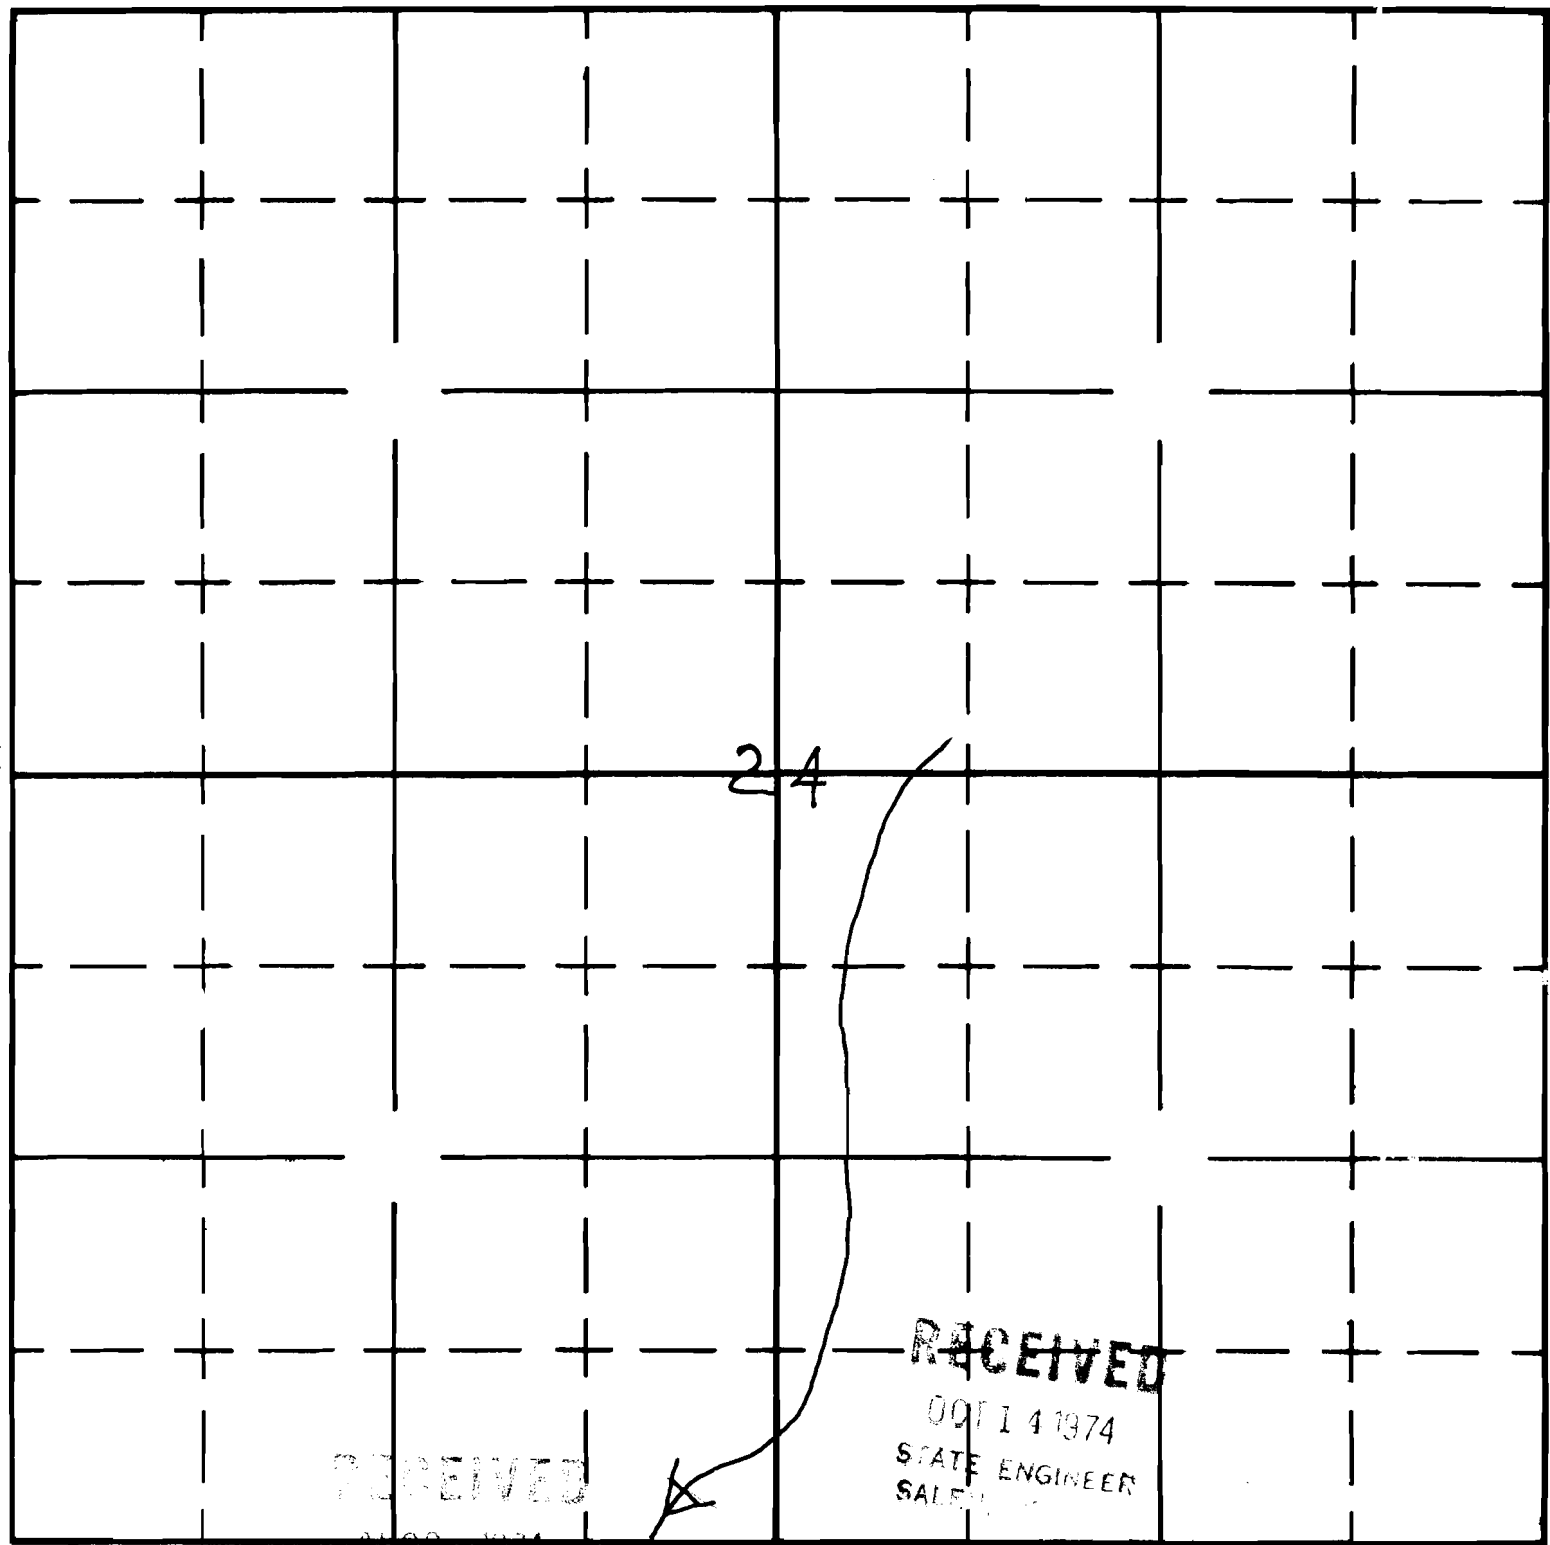

RECEIVED

RECEIVED

00114 1974
STATE ENGINEER
SALE

South

STATE ENGINEER
SALE

APPLICATION No. 12-52285
PERMIT No. 7447