


UNITED STATES
DEPARTMENT OF THE INTERIOR
BUREAU OF LAND MANAGEMENT

4
N

SECTION
SE⁴NE⁴
SEC 31

Oregon State Water Filings
TOWNSHIP 35S, RANGE 45E, W. M.

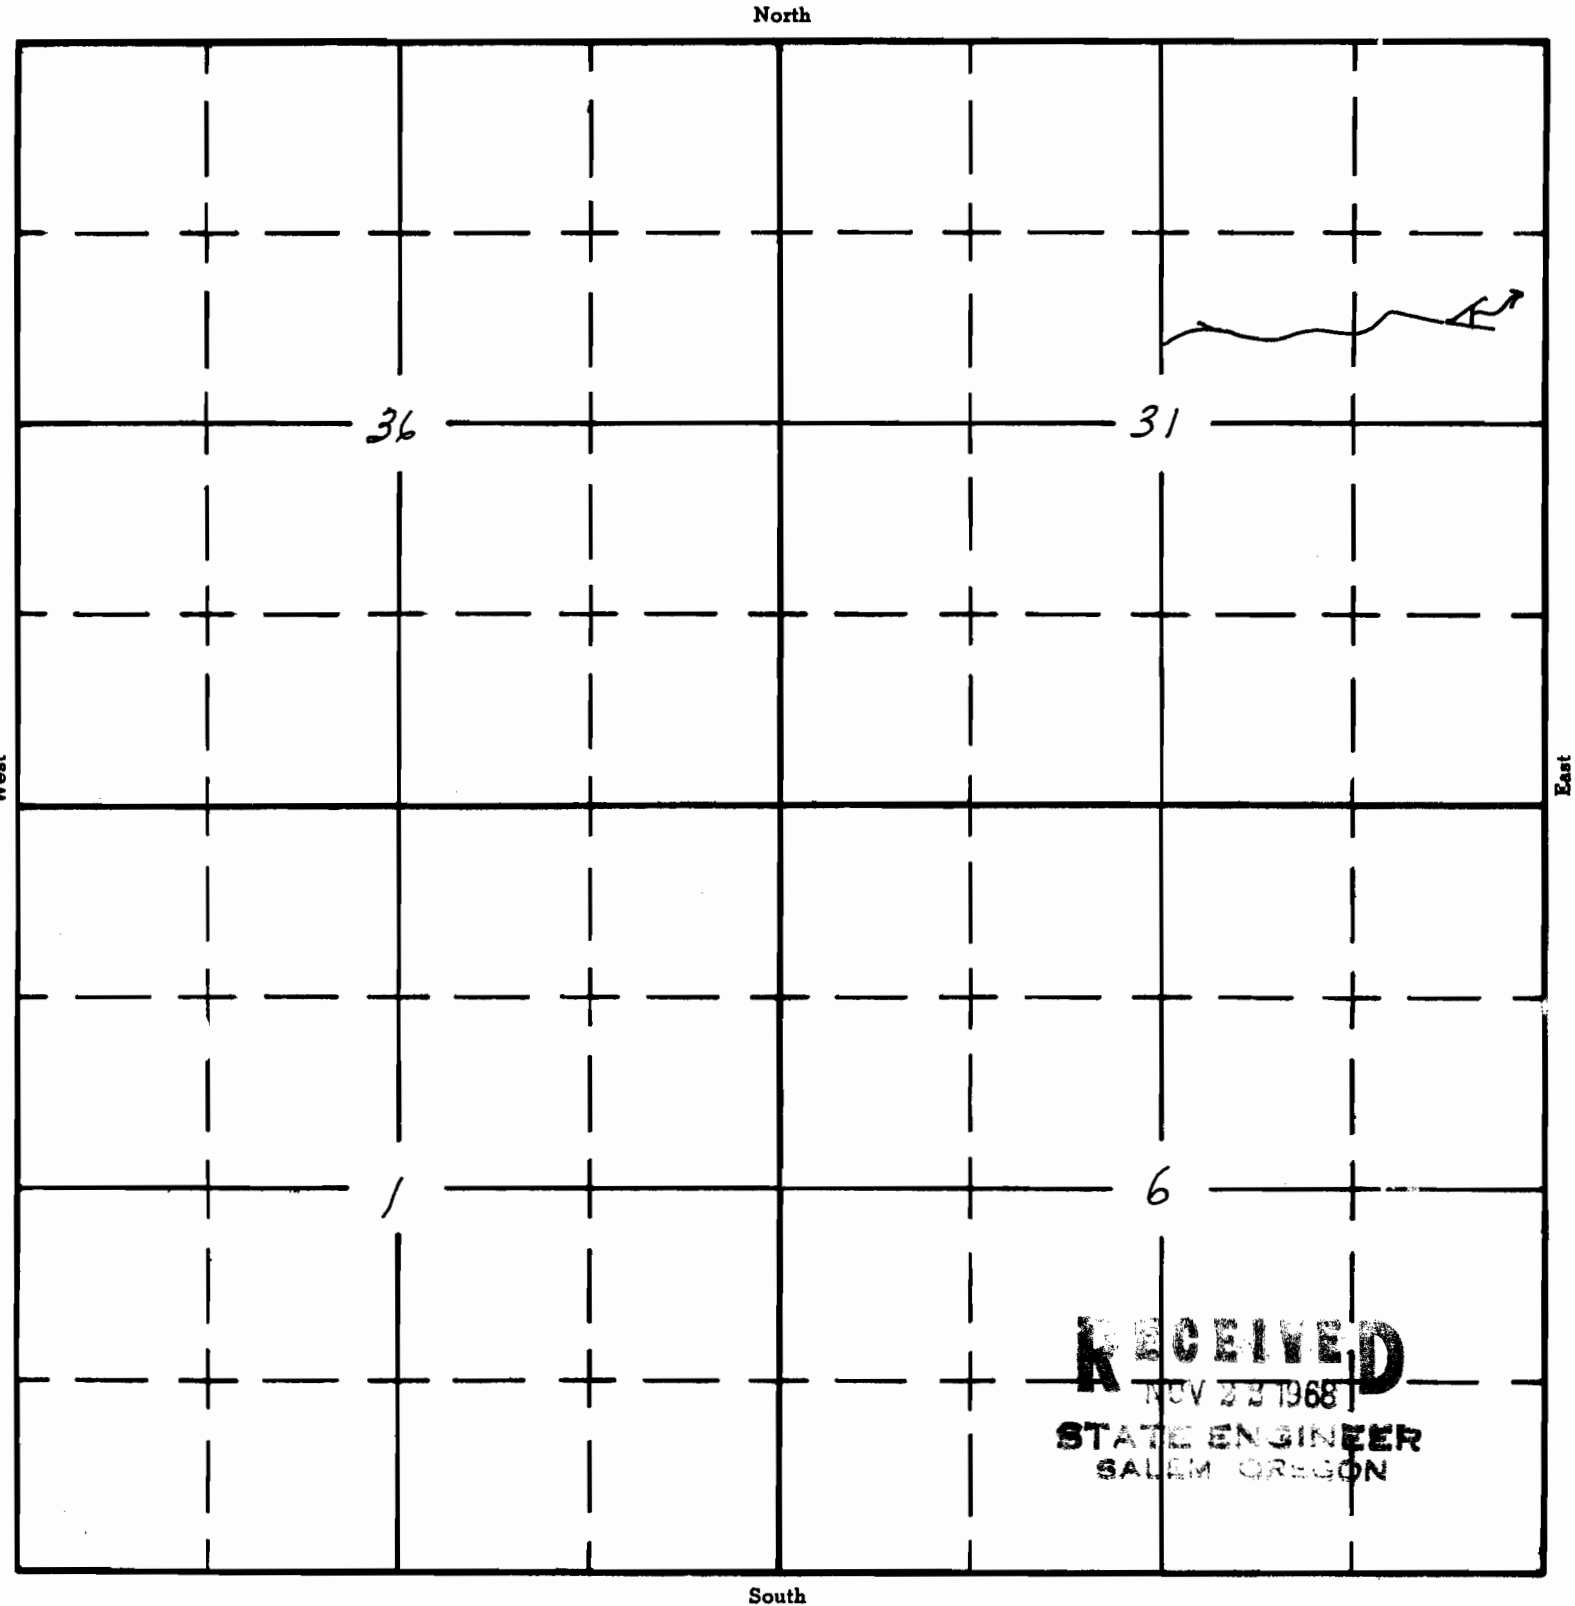

5 Bar Res.

APPLICATION No. R-45586
PERMIT No. R 7465