


Form AI-187
March 1961

UNITED STATES
DEPARTMENT OF THE INTERIOR
BUREAU OF LAND MANAGEMENT

SECTION
9
SW⁴
SE⁴

Oregon State Water Filings

TOWNSHIP 28 S, RANGE 37 E, W. M.

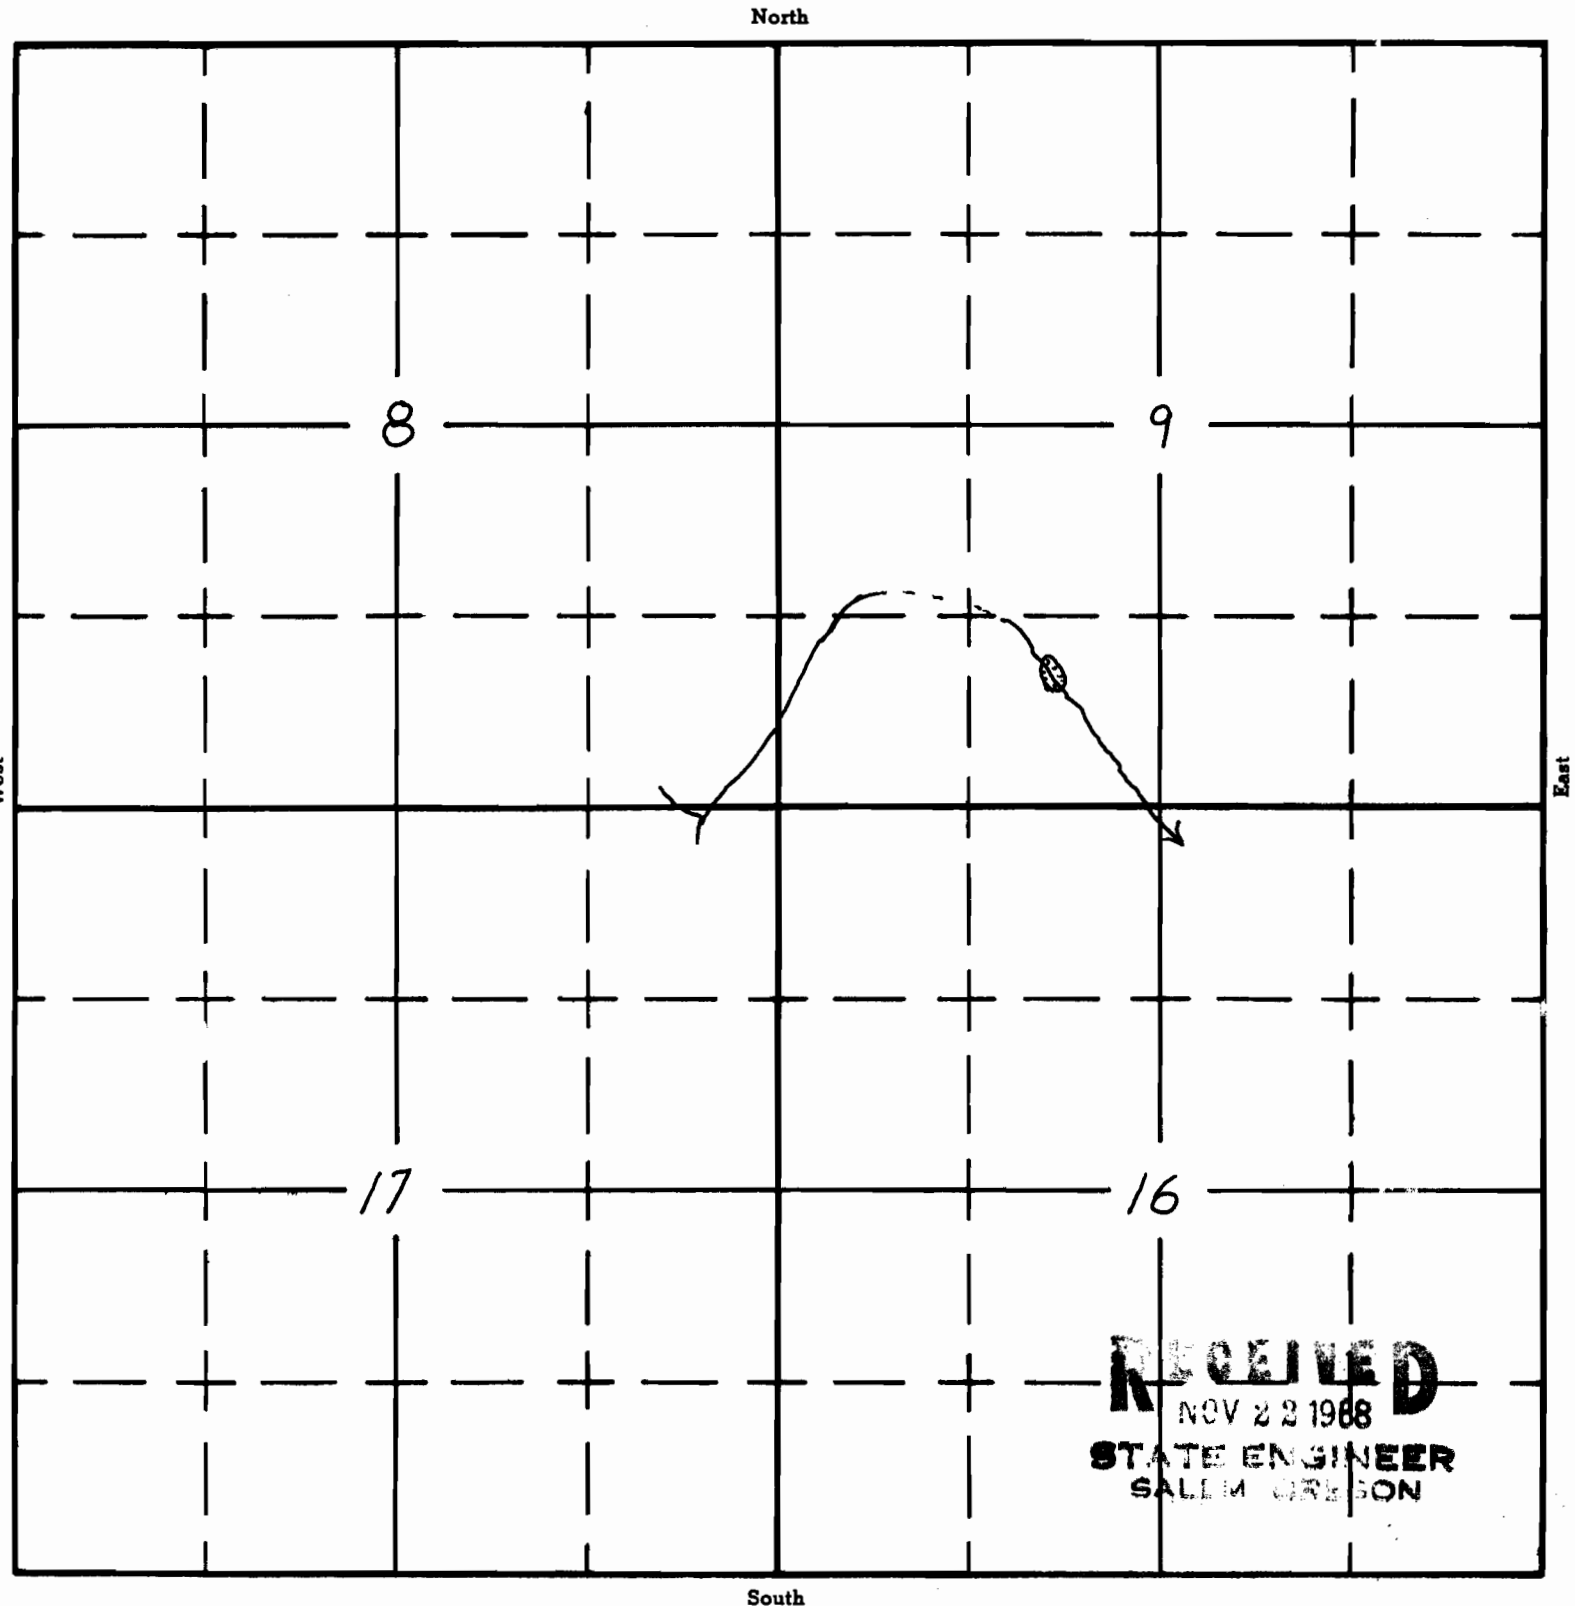

RECEIVED
NOV 22 1968
STATE ENGINEER
SALIM OREGON

Sheep Camp Pit

APPLICATION No. R-45592
PERMIT No. 7471