


UNITED STATES
DEPARTMENT OF THE INTERIOR
BUREAU OF LAND MANAGEMENT

SECTION 20
SW⁴ NE⁴

Oregon State Water Filings

TOWNSHIP 23 S., RANGE 45 E., W. M.

North

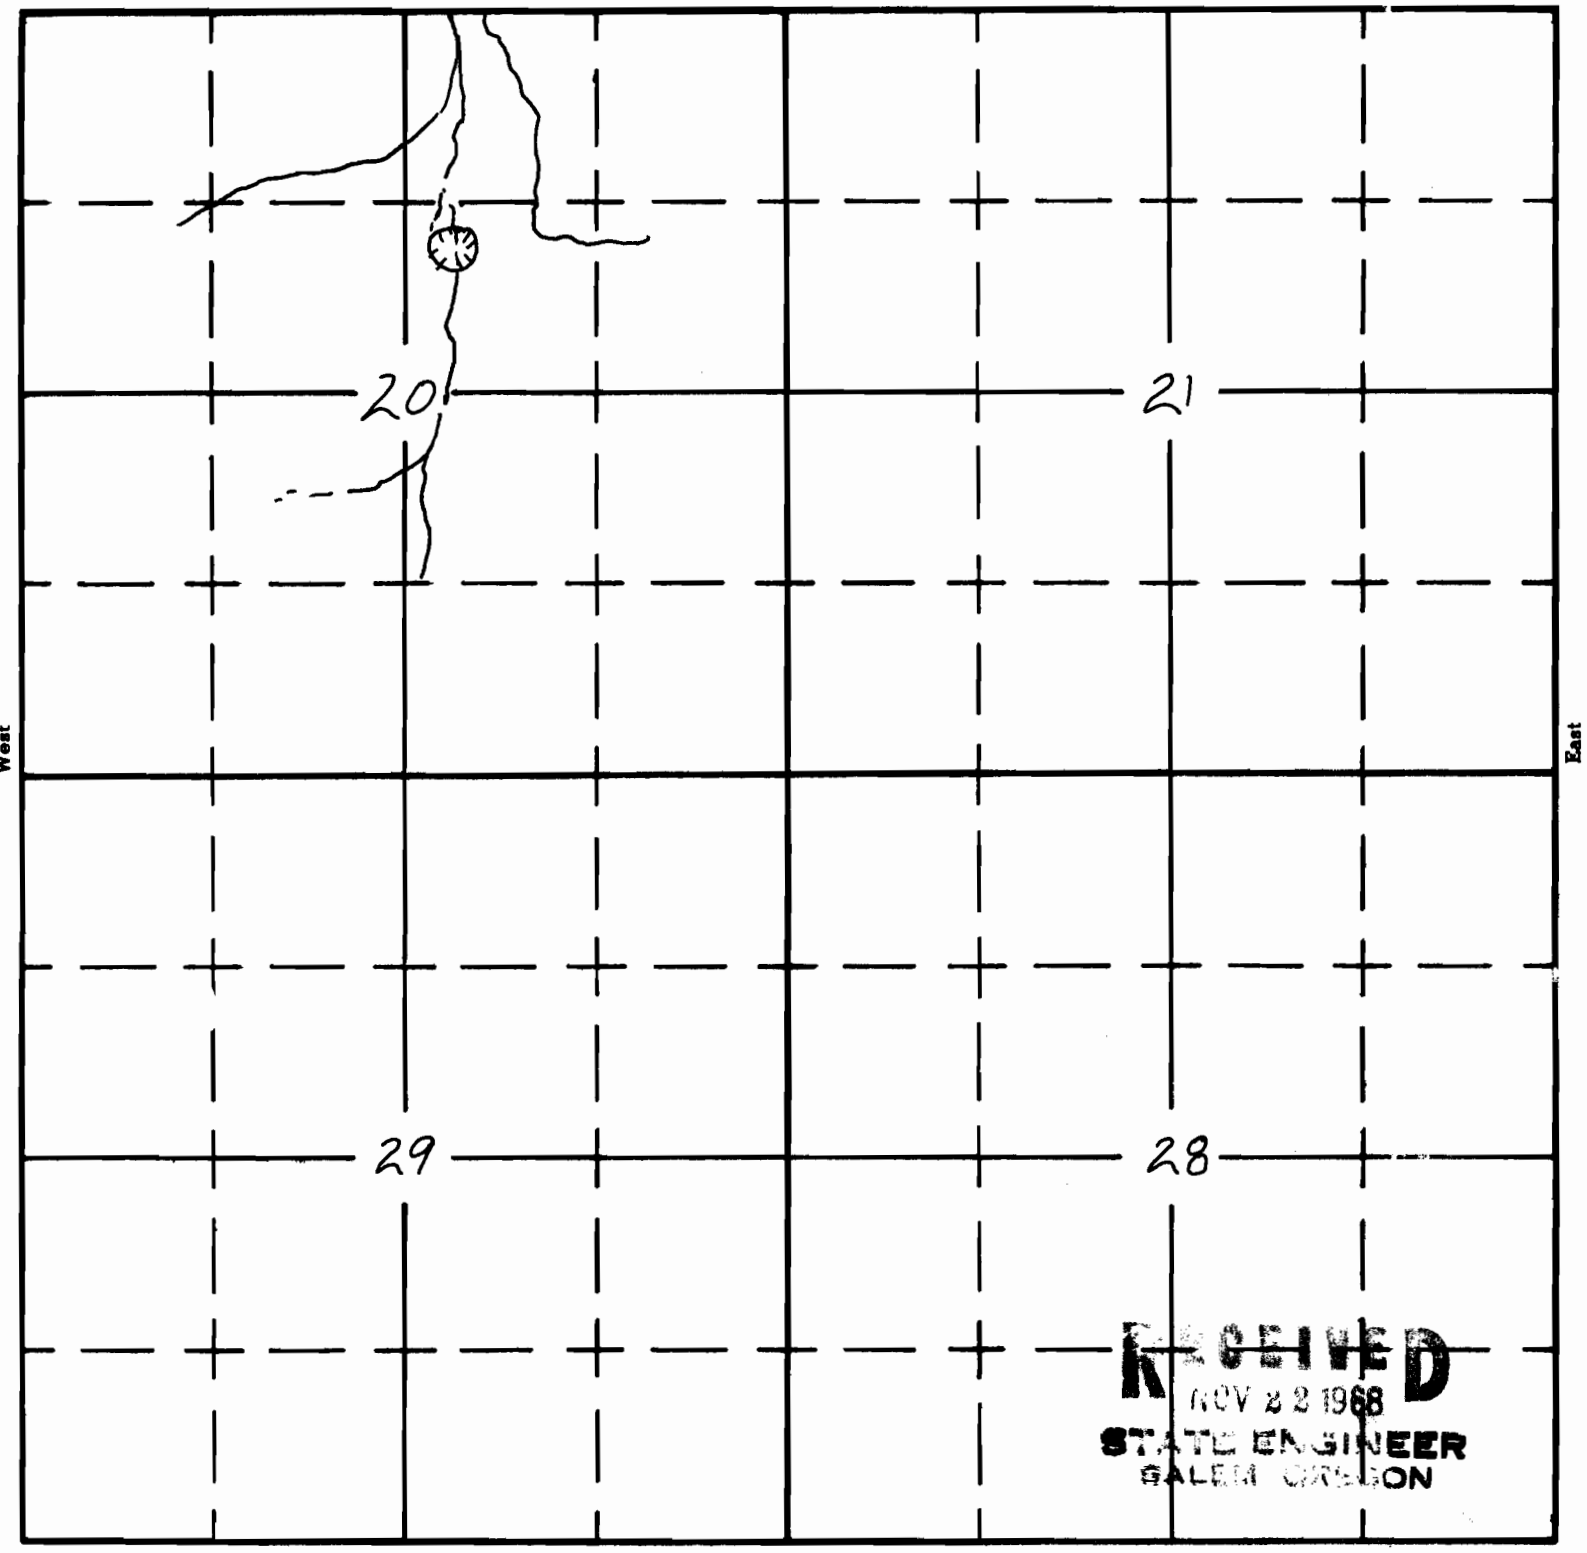

Birch Creek Pit

South

RECEIVED
NOV 22 1968
STATE ENGINEER
SALEM OREGON

APPLICATION No. R-45597
PERMIT No. 7174