

UNITED STATES
DEPARTMENT OF THE INTERIOR
BUREAU OF LAND MANAGEMENT




SECTION
SW⁴NE⁴
Sec 27

Oregon State Water Filings

TOWNSHIP 24S, RANGE 45E, W. M.

North

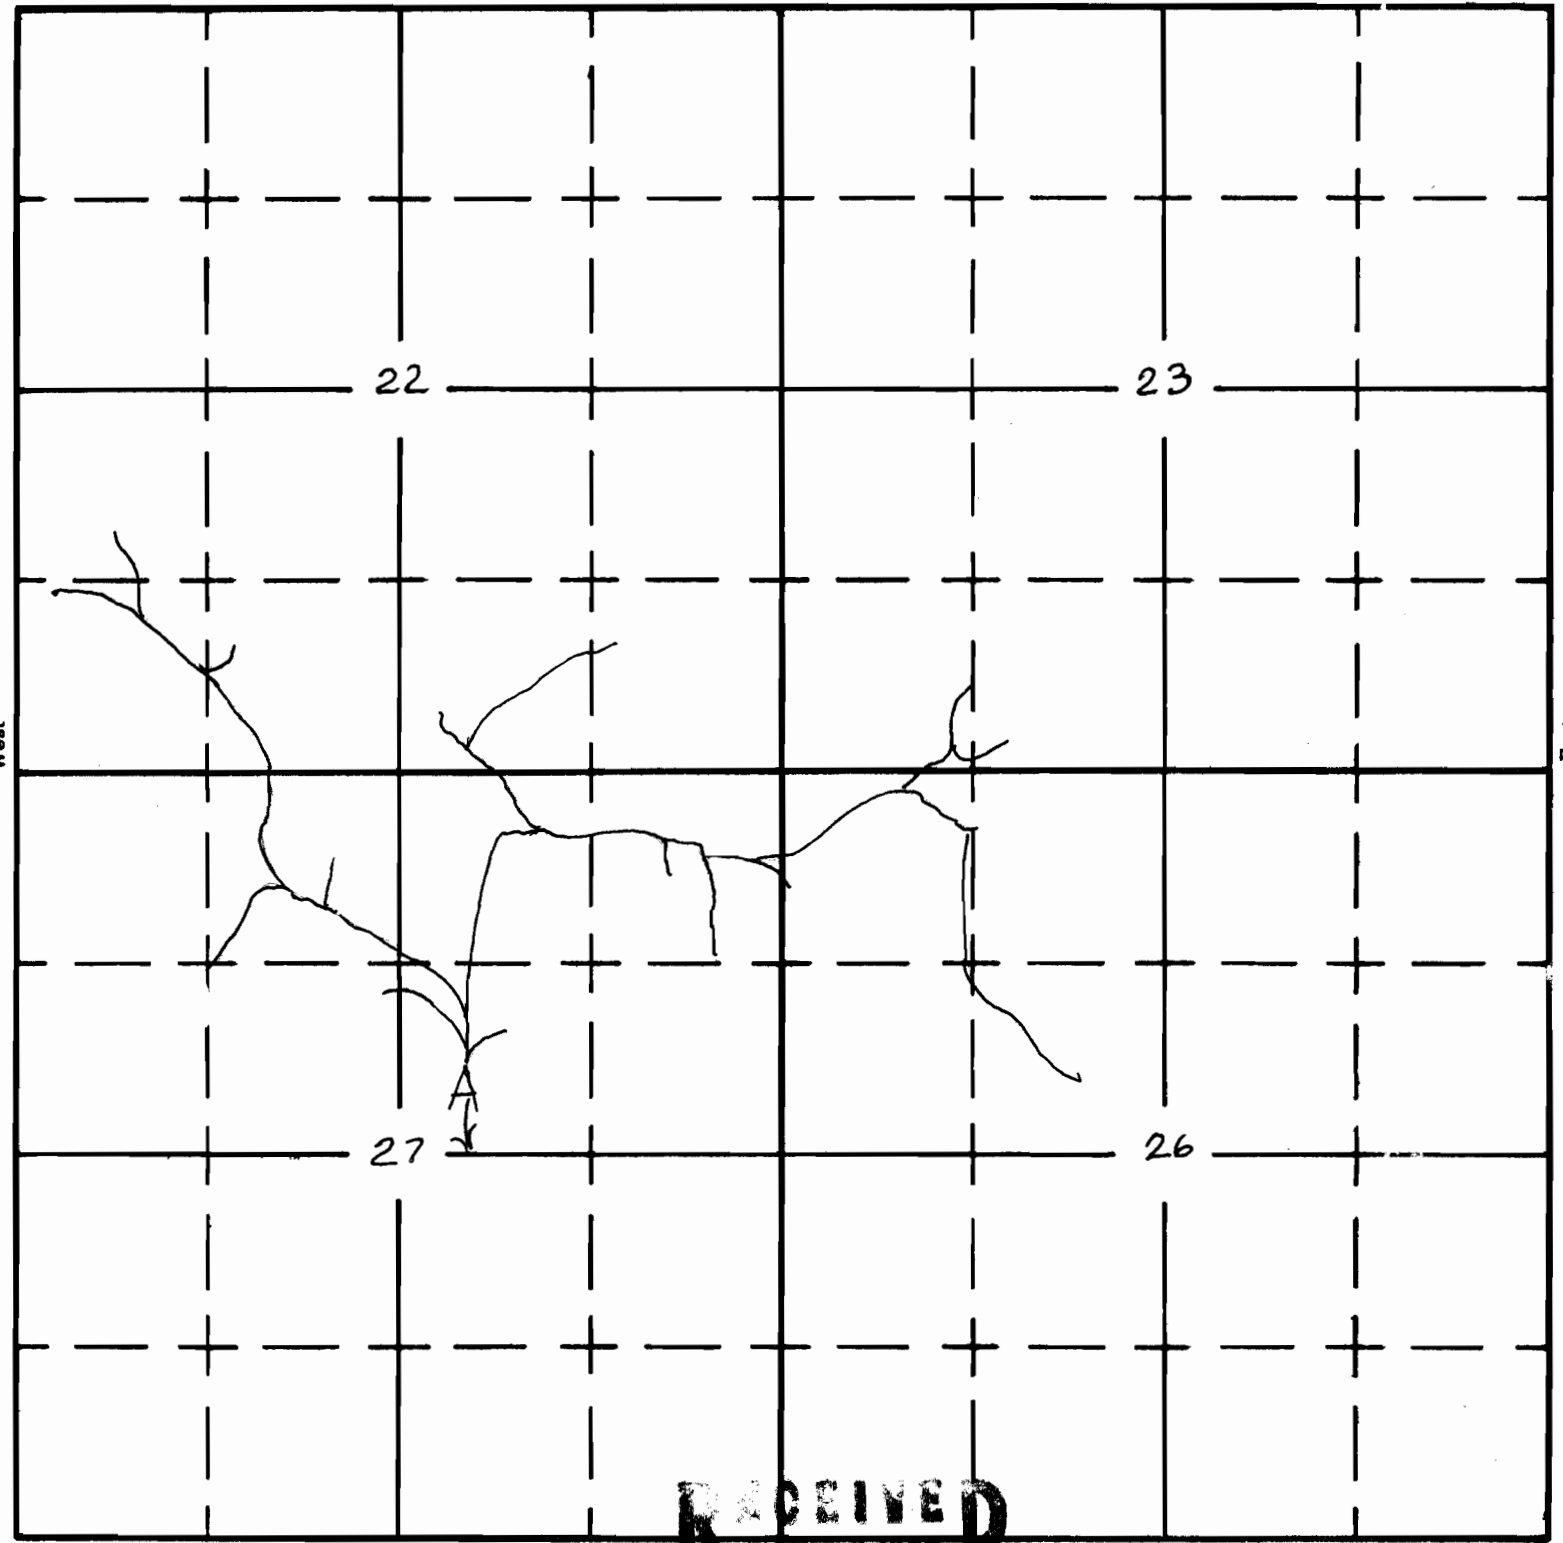

RECEIVED
MAY 29 1968

STATE ENGINEER
SALEM, OREGON

APPLICATION No. R-45599
PERMIT No. R 7476

Potts Res.