


UNITED STATES  
DEPARTMENT OF THE INTERIOR  
BUREAU OF LAND MANAGEMENT

# Oregon State Water Filings

SECTION  
13  
SE<sup>4</sup> NE<sup>4</sup>

TOWNSHIP 25 S., RANGE 46 E., W. M.

North

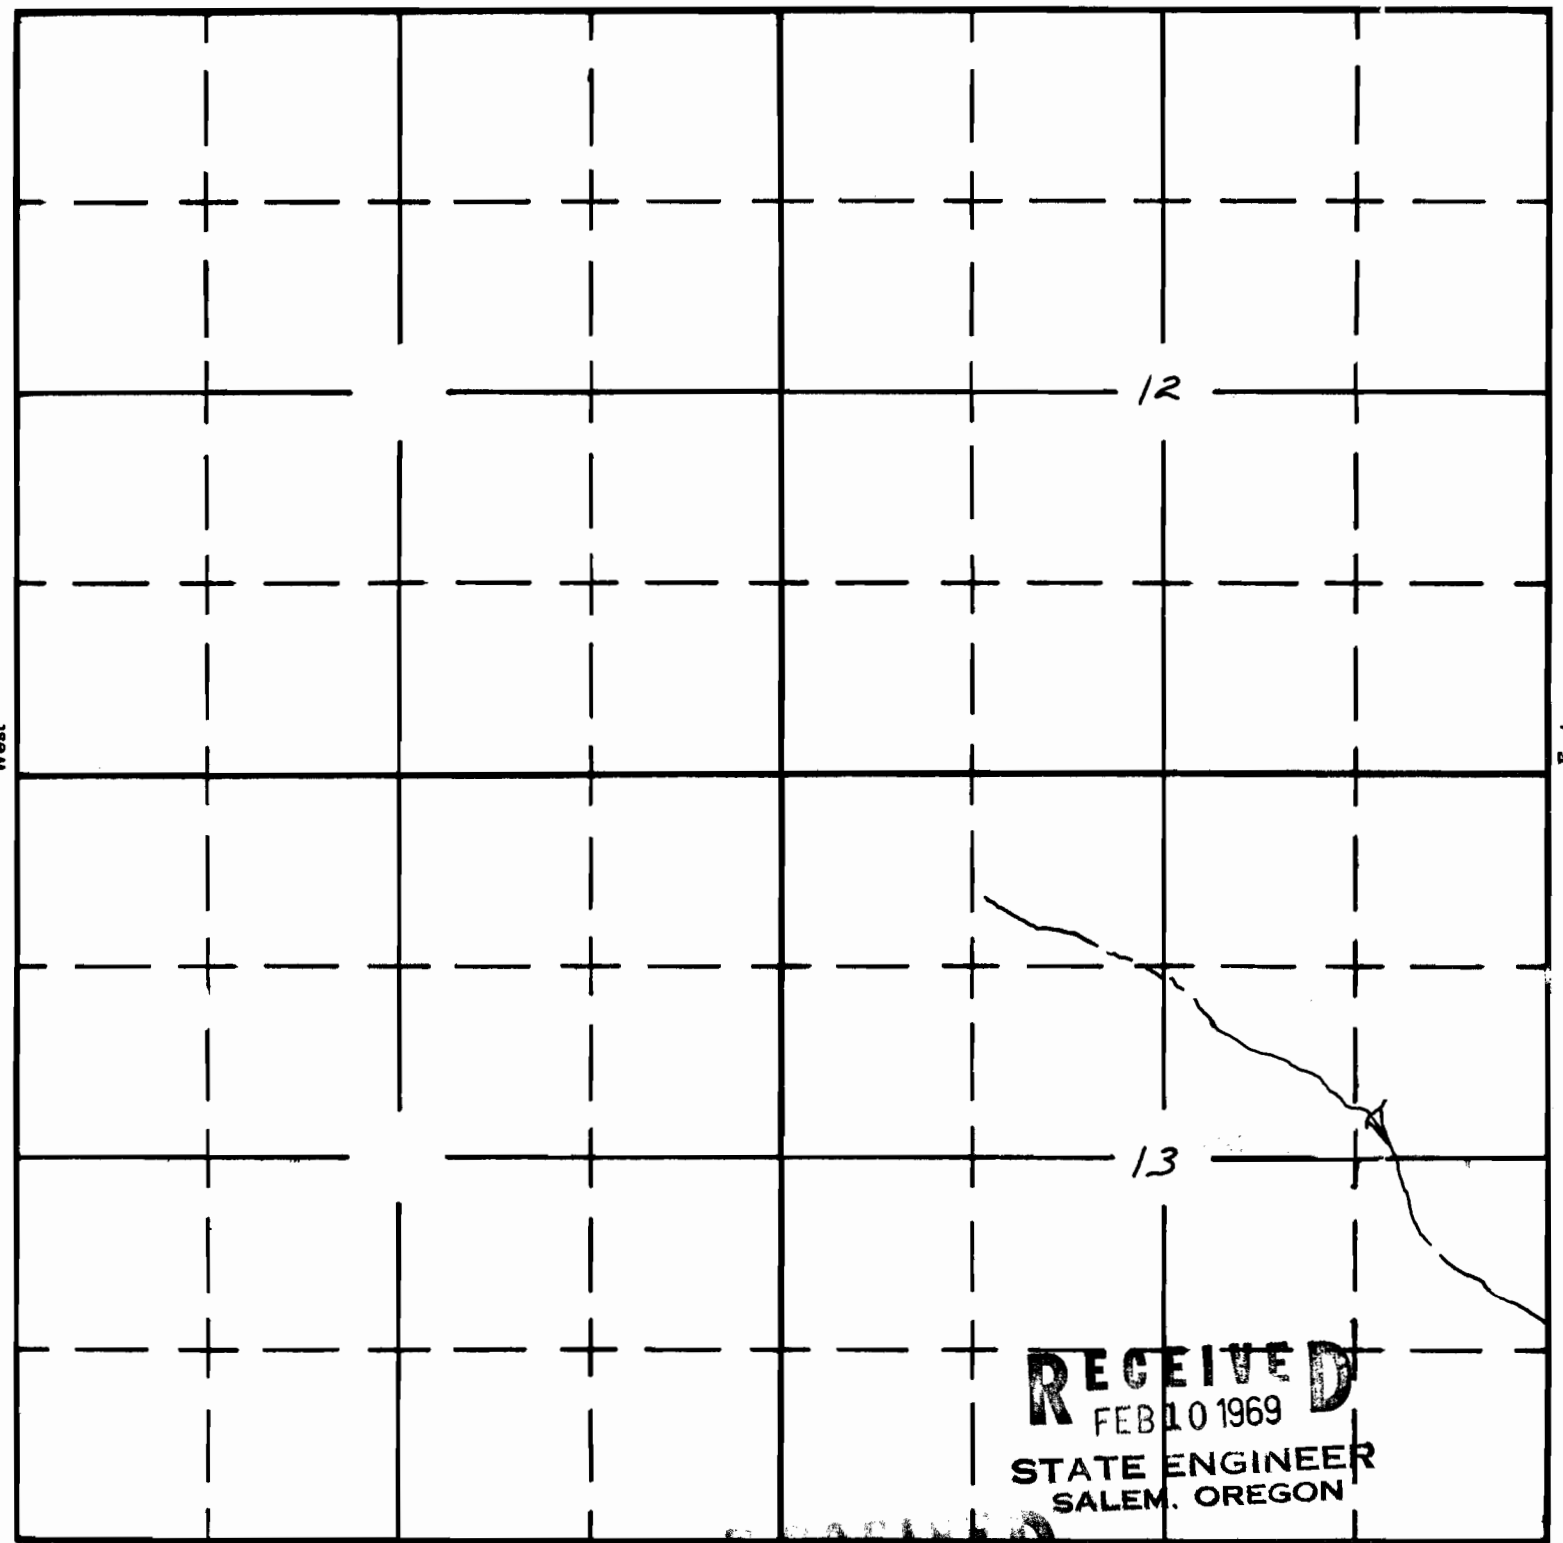

**RECEIVED**  
FEB 10 1969  
STATE ENGINEER  
SALEM, OREGON

*Lillie Res.*

**RECEIVED**  
NOV 28 1968  
STATE ENGINEER  
SALEM, OREGON

APPLICATION No. R-45602  
PERMIT No. R 7479