


UNITED STATES
DEPARTMENT OF THE INTERIOR
BUREAU OF LAND MANAGEMENT

SECTION SE⁴ SE⁴ Oregon State Water Filings

Sec 16 TOWNSHIP 29S, RANGE 45E, W. M.

North

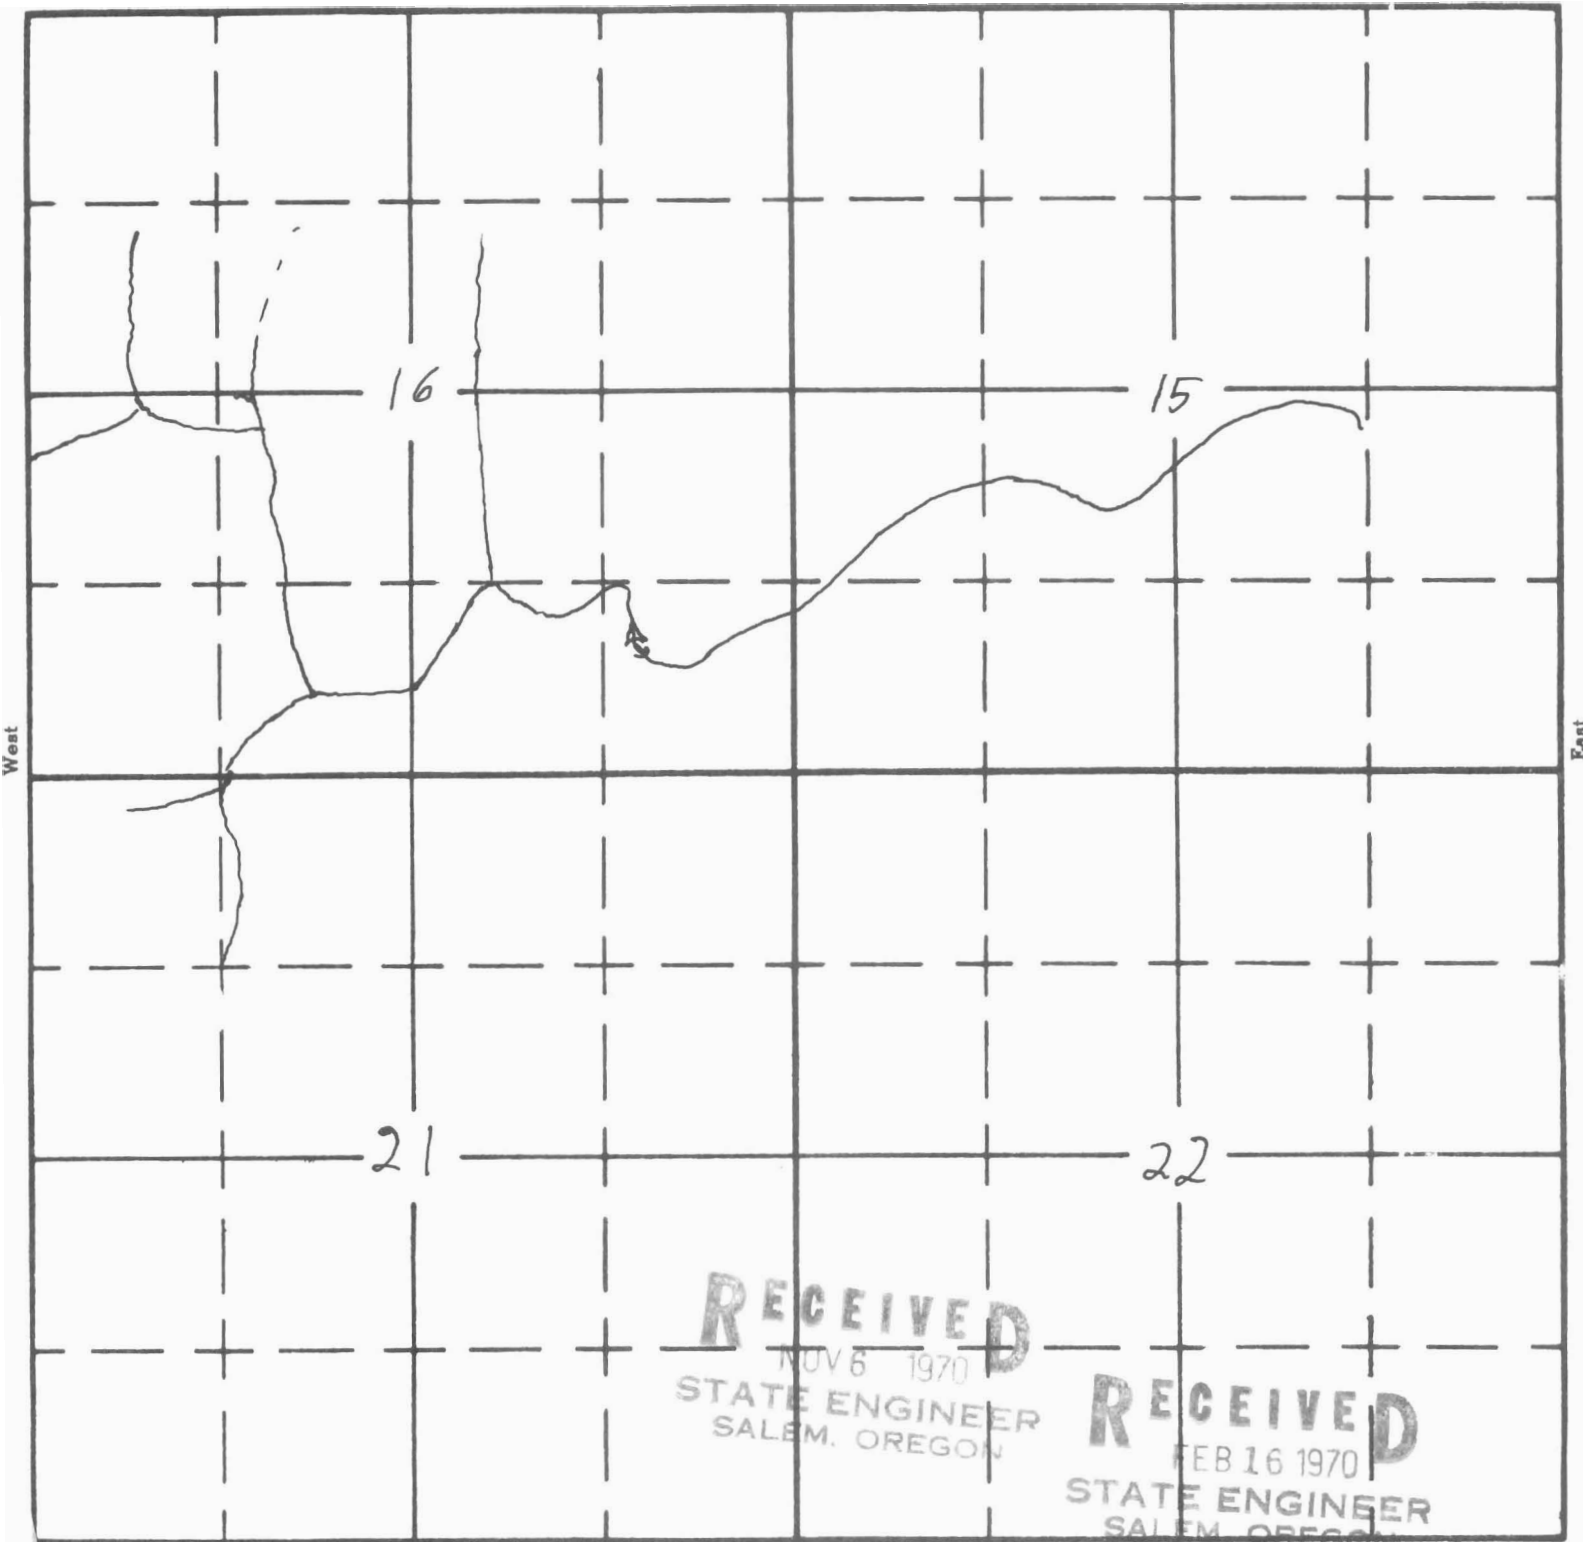

RECEIVED
NOV 6 1970
STATE ENGINEER
SALEM, OREGON

RECEIVED
FEB 16 1970
STATE ENGINEER
SALEM, OREGON

Easement Res.

APPLICATION No. 407
PERMIT No. 312