

Form AI-187  
March 1961

UNITED STATES  
DEPARTMENT OF THE INTERIOR  
BUREAU OF LAND MANAGEMENT

SECTION


SE<sup>1</sup> SE<sup>1</sup>


TOWNSHIP 27 S, RANGE 44 E, W. M.

Sec. 35

North

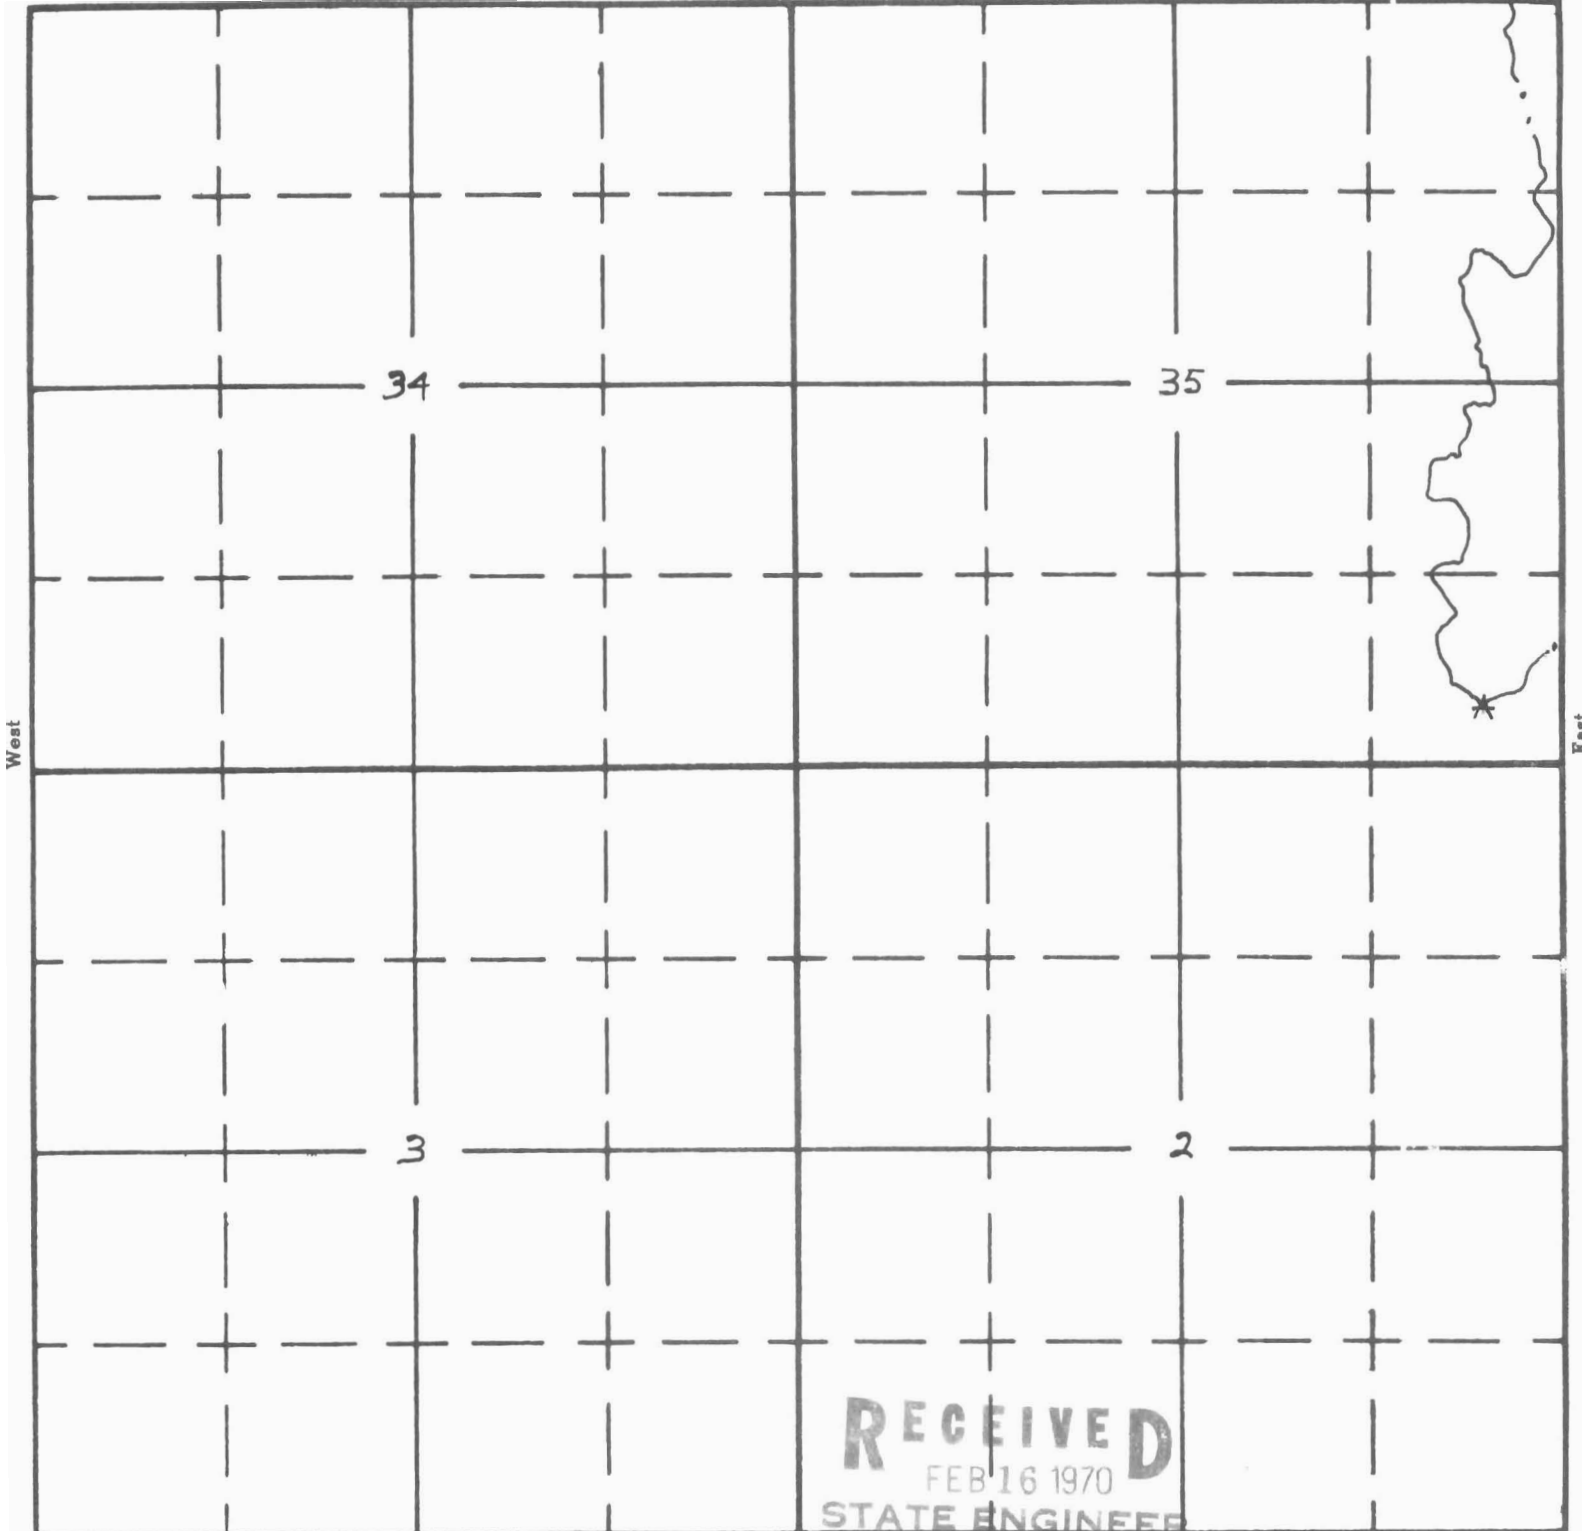

HANG UP RES.

South

APPLICATION No. 4-100  
PERMIT No. 2495