

UNITED STATES
DEPARTMENT OF THE INTERIOR
BUREAU OF LAND MANAGEMENT

SECTION


Oregon State Water Filings

NW⁴ SW⁴

TOWNSHIP 39 S., RANGE 43 E., W. M.

Sec 7

North

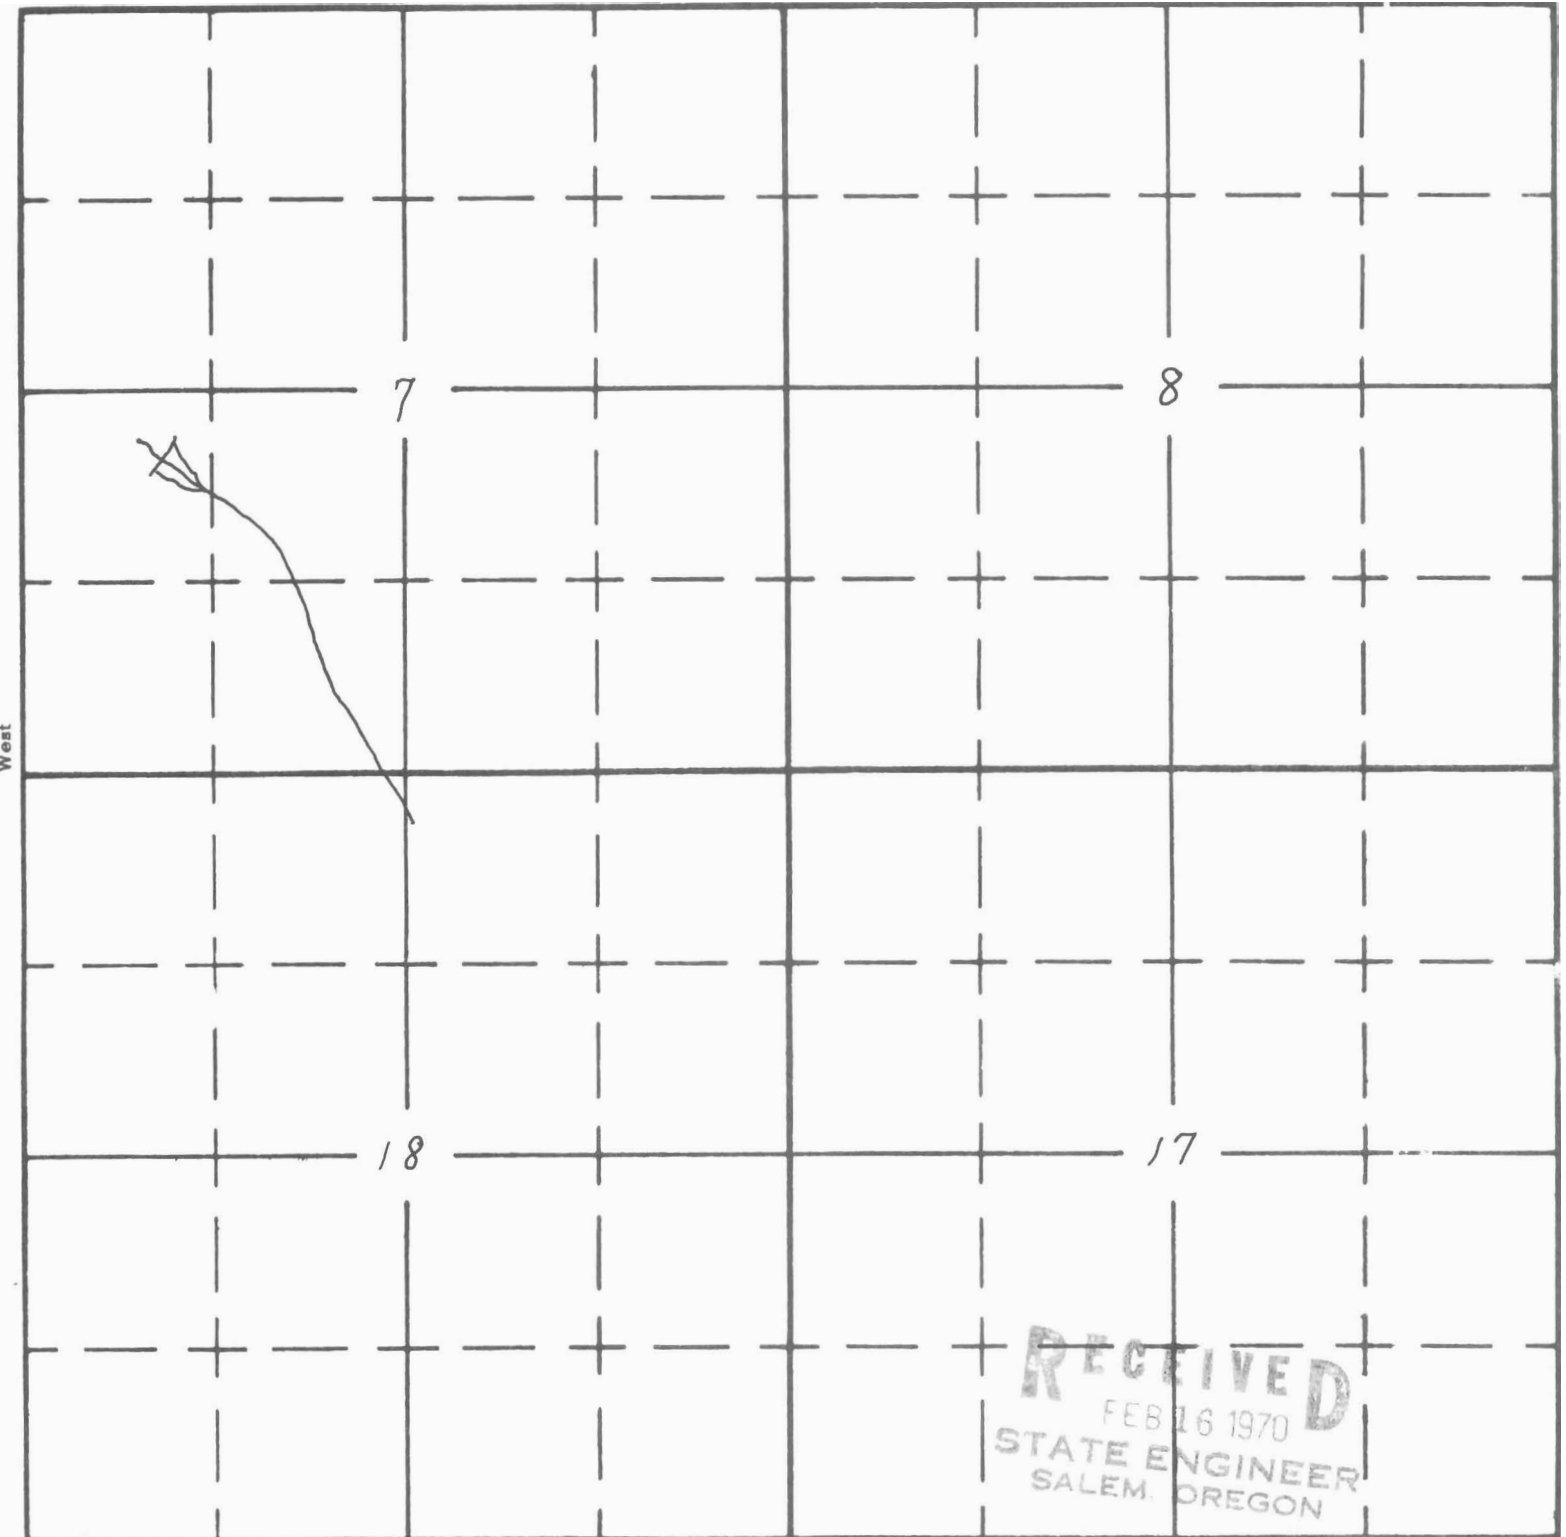

RECEIVED
FEB 16 1970
STATE ENGINEER
SALEM, OREGON

South

Jenny Res.

APPLICATION No. 1000
PERMIT No. 1000