


G-6919
58063

T.40 S., R.19 E., W.M.

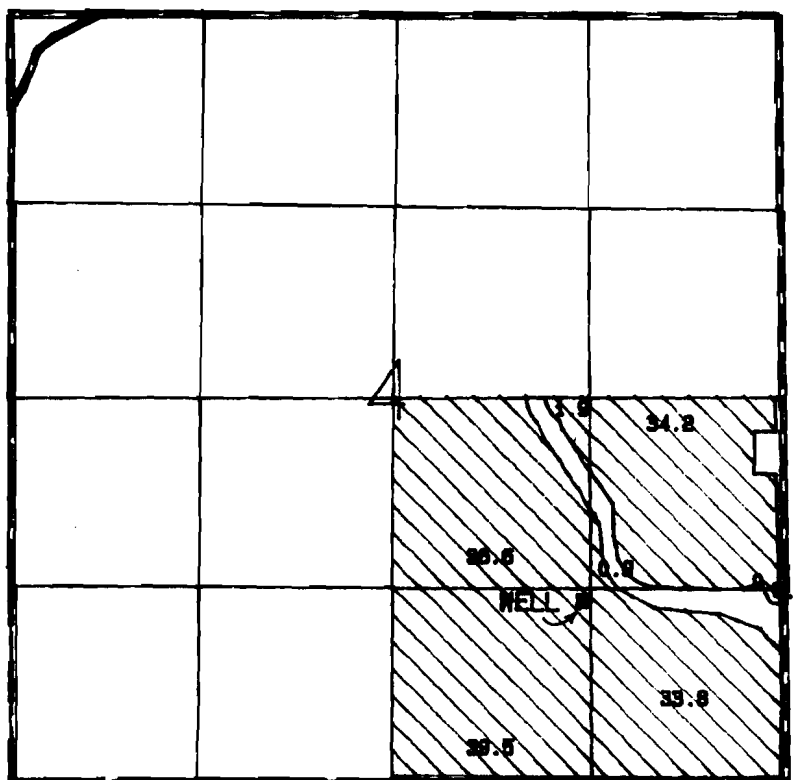

SCALE: 1" = 1320'

WELL. LOCATED 1300 FT. N. AND 1320 FT. W. FROM S.E. COR. 4

FINAL PROOF SURVEY
UNDER

Application No. 6-7415 Permit No. 6-6919

IN NAME OF

WARREN G. CONGER

Surveyed Oct. 16, 1987 By B.S. JAMES

Photo: 379-960 DLM