


T.14S. R.13E. W.M.

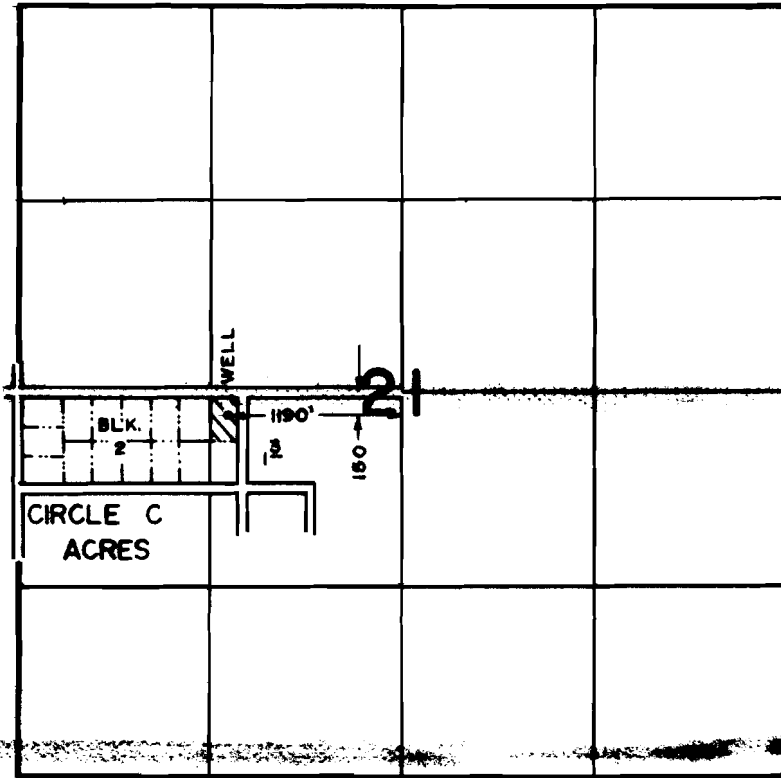

FINAL PROOF SURVEY
UNDER

Application No. G-7886. Permit No. G-7387.....
IN NAME OF

SHERMAN & MARY ELIZABETH CRAWFORD

Surveyed APR. 17. 1980., by L.H. NUNN.....

204,57064