


T. 6 S., R. 2 W., W.M.

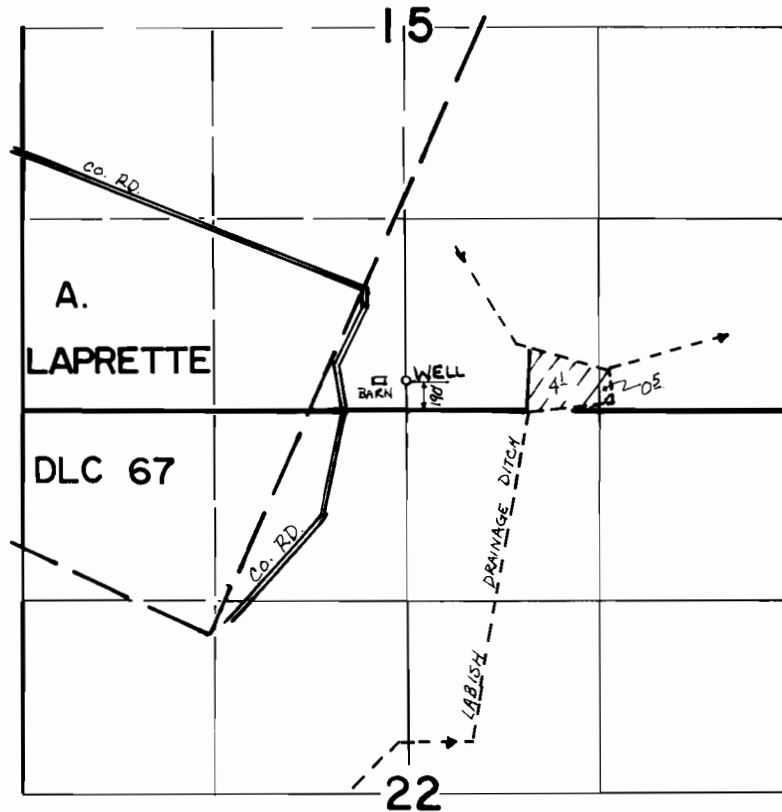

FINAL PROOF SURVEY UNDER

Application No. G 7876 Permit No. G 7727
IN NAME OF

ROBERT HEILMAN

Surveyed OCT. 24, 1983, by M. CAHILL