


T. 35S., R. 5W., W.M.

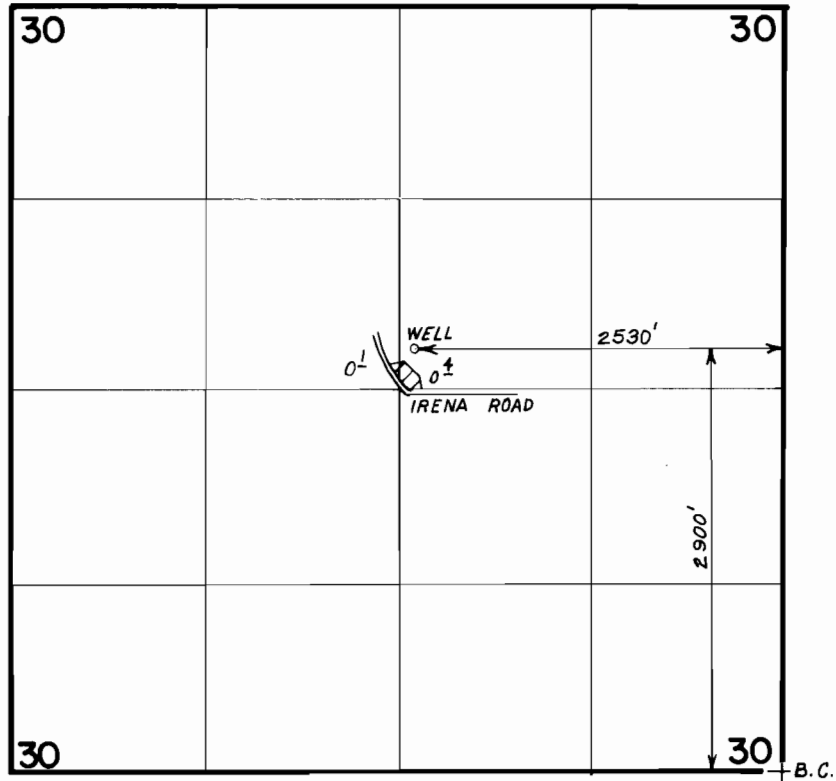

SCALE: 1" = 1320'

FINAL PROOF SURVEY
UNDER

Application No. G-8411, Permit No. G-7774
IN NAME OF

JACK R. THOMAS

Surveyed JULY 10, 1984, by B. S. JAMES