


T. 1S., R. 3W., W. M.

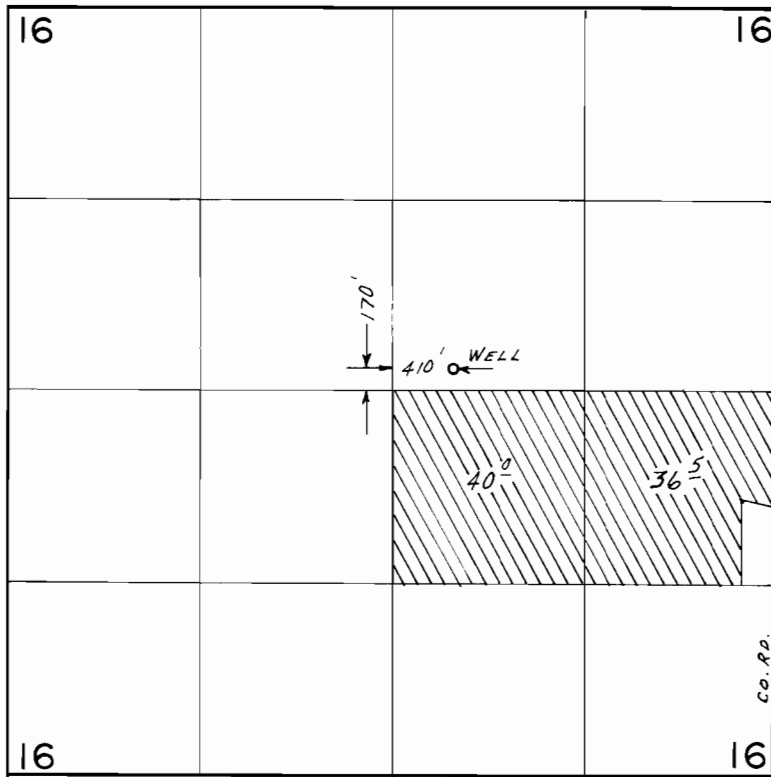

SCALE: 1" = 1320

FINAL PROOF SURVEY UNDER

Application No. G-8238. Permit No. G-7800.....
IN NAME OF

.....DONALD C. JESSE.....

Surveyed ..Aug. 23.. 19.84, by B.W. BISHOP.....