


T.38 S., R.19 E., W.M.

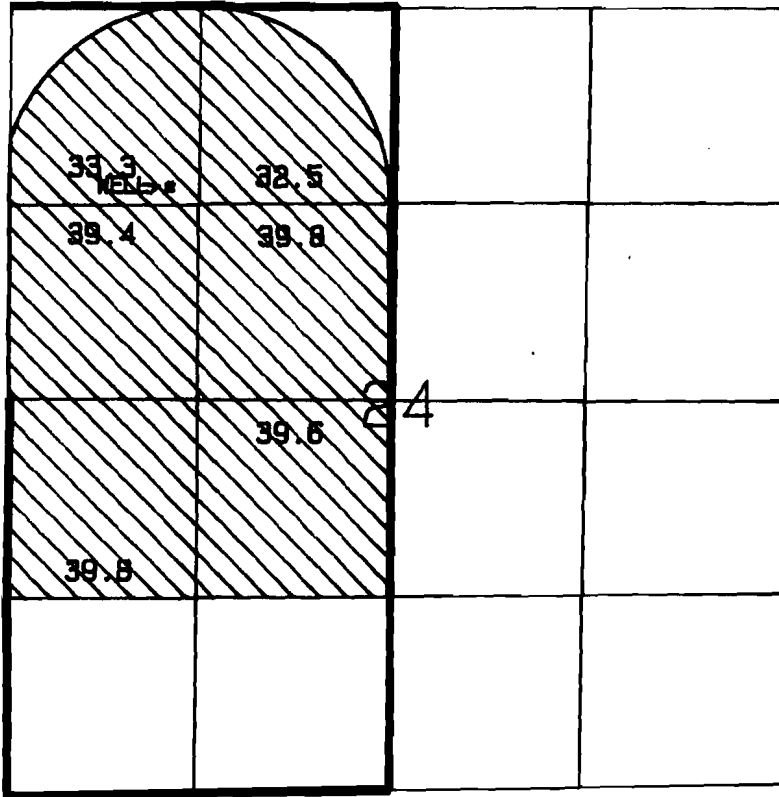

WELL LOCATED 1220 FT. S. AND 1100 FT. E. FROM NW COR. SEC 24

SCALE: 1" = 1320'

FINAL PROOF SURVEY

UNDER

Application No. 6-8495 Permit No.6-8194

IN NAME OF

GEORGE & ELIZABETH JASKA

Surveyed Oct. 19, 1987 By B.S.JAMES

Photo: 378 101R DLM