


T.41 S., R.18 & 19 E., W.M

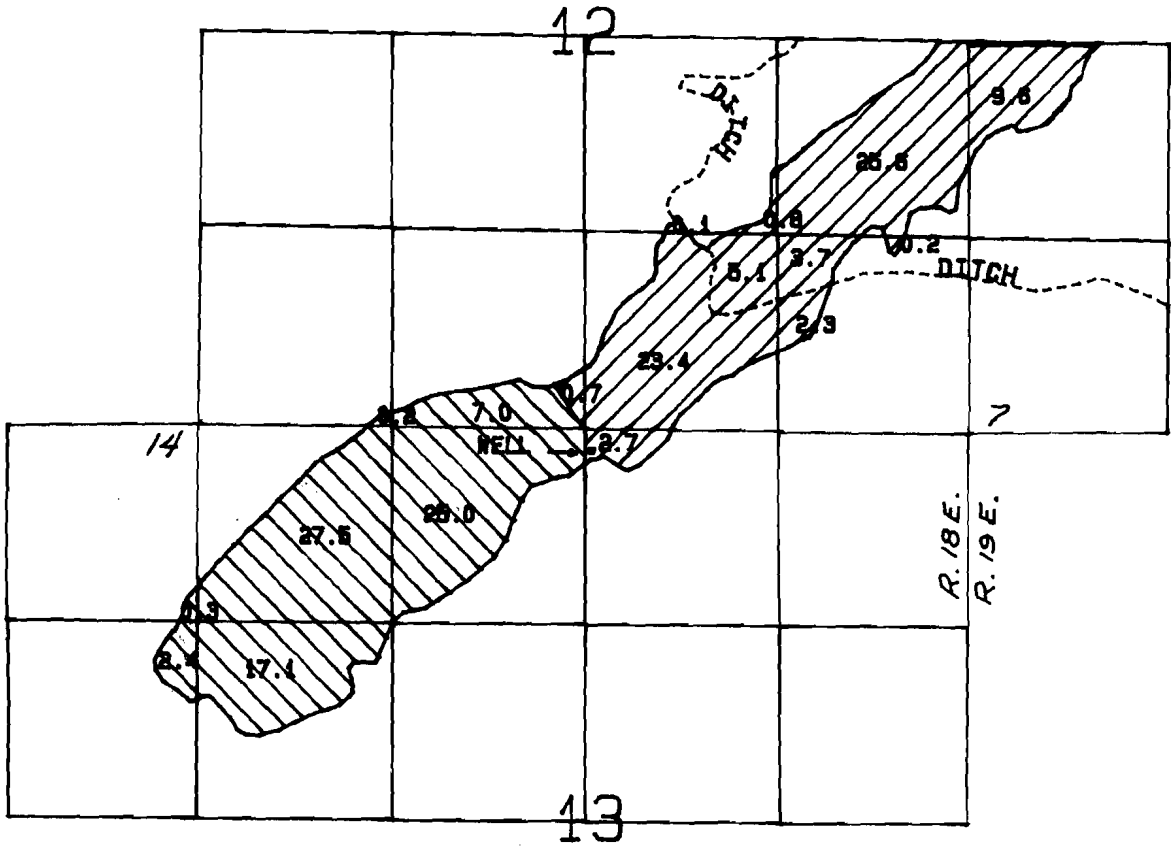

WELL LOCATED 150 FT. S. AND 50 FT. E. FROM S. 1/4. COR. SEC 12

FINAL PROOF SURVEY

UNDER

APPLICATION NO. 6-8782 PERMIT NO. 6-8249
6-10409 6-9659

IN NAME OF

DEPT. VETERANS AFFAIRS

SCALE: 1 IN. = 1320 FT.

Surveyed Oct. 18, 1987 By B.S. JAMES

Photo: 379-87D DLM