



T.41 S., R.18 & 19 E., W.M

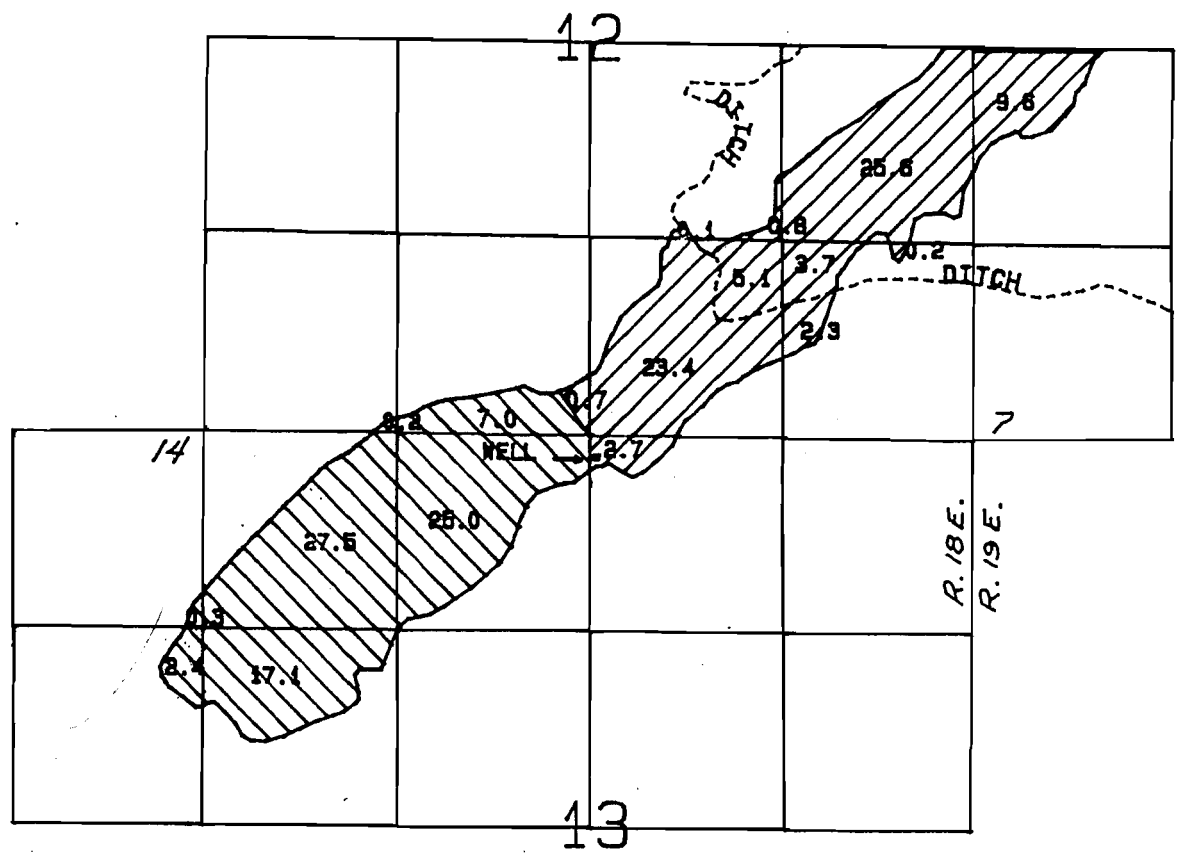


G-8249

G-9659

WELL LOCATED 150 FT. S. AND 50 FT. E. FROM S. 1/4. COR. SEC 12

FINAL PROOF SURVEY

UNDER

APPLICATION NO. G-8782 PERMIT NO. G-8249
G-10409 G-9659

IN NAME OF
DEPT. VETERANS AFFAIRS

SCALE: 1 IN. = 1320 FT.

Surveyed Oct. 18, 1987 By B.S. JAMES

Photo: 379-87D DLM