


G-8424
58675

T.1S.,R.32E.,W.M.

Application No. G 8711

Permit No. G 8424

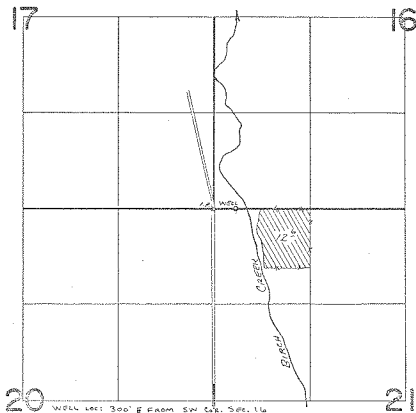

FINAL PROOF SURVEY
UNDER

Application No. G-4087 Permit No. G-3870.
IN NAME OF

RAYMOND SLABIK

Surveyed APRIL 5, 1975, by L. Toll