


G-8708
T8539

T. 39 S., R. 19 E., W.M.

58076

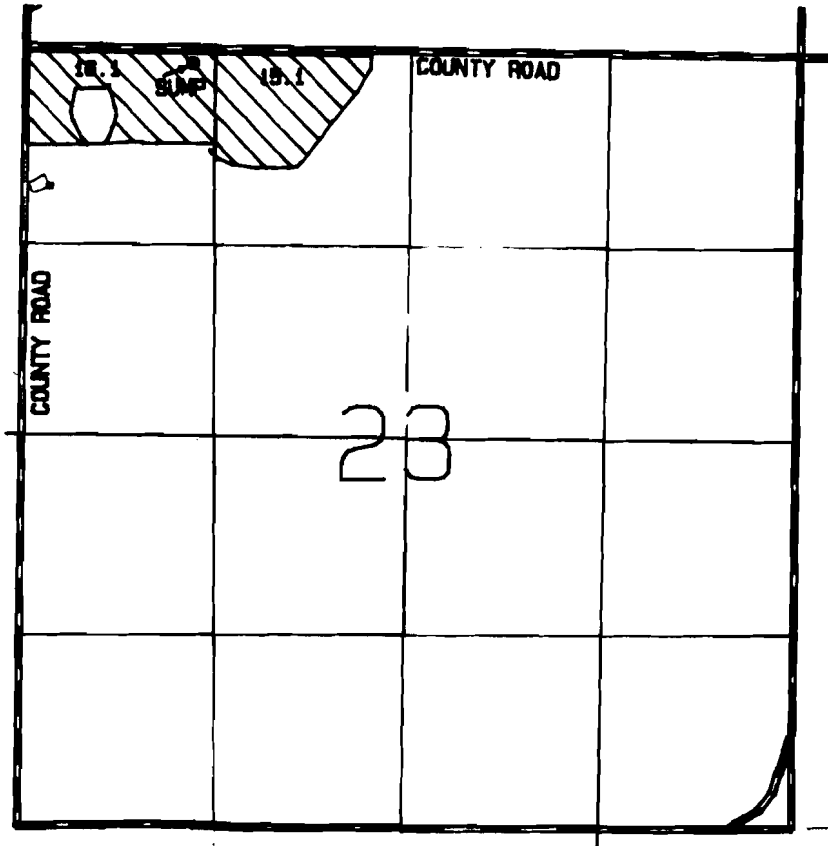

SCALE: 1" = 1320'
SUMP LOCATED 120 FT. S. AND 150 FT. E. FROM NW COR. SEC. 23

FINAL PROOF SURVEY
UNDER

Application No. 6-9282 Permit No. 6-8708

IN NAME OF

BILLY R. AND BETTY L. MORRIS

Surveyed Oct. 15, 1987 By T.M. WARREN

Photo: 41037 479 98A LN