


T. 39 S., R. 19 E., W.M.

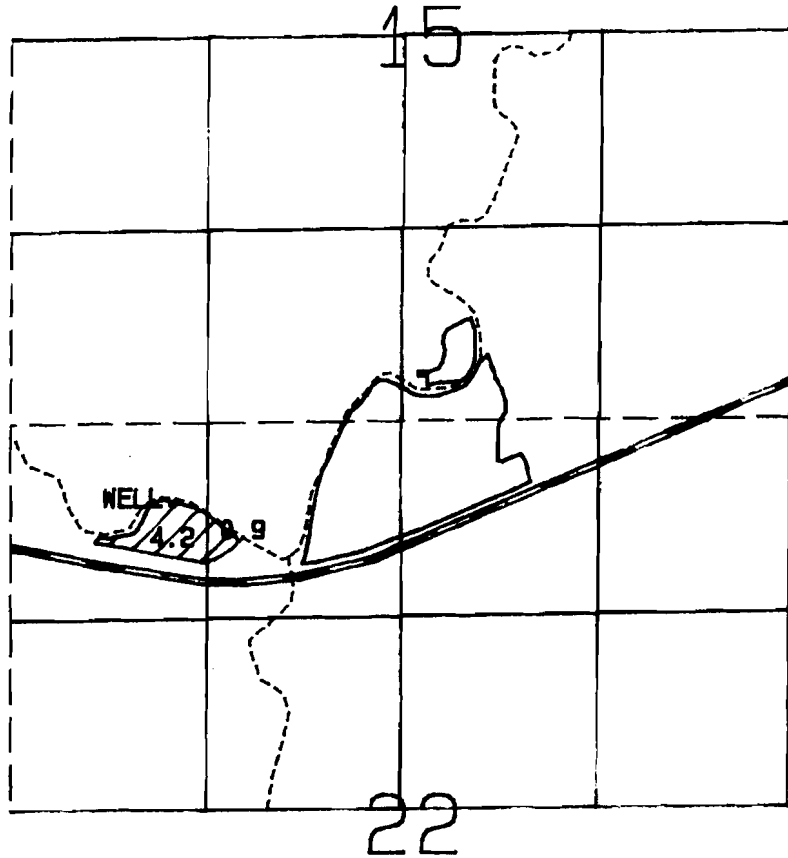

SCALE: 1" = 1320'

DIV. PT. LOCATED 500 FT. S. AND 1080 FT. E. FROM SW. SEC COR. SEC 15

FINAL PROOF SURVEY

UNDER

Application No. G-10492 Permit No. G-9662

IN NAME OF

Ben M. Morris