


T. 39 S., R. 19 E., W. M.

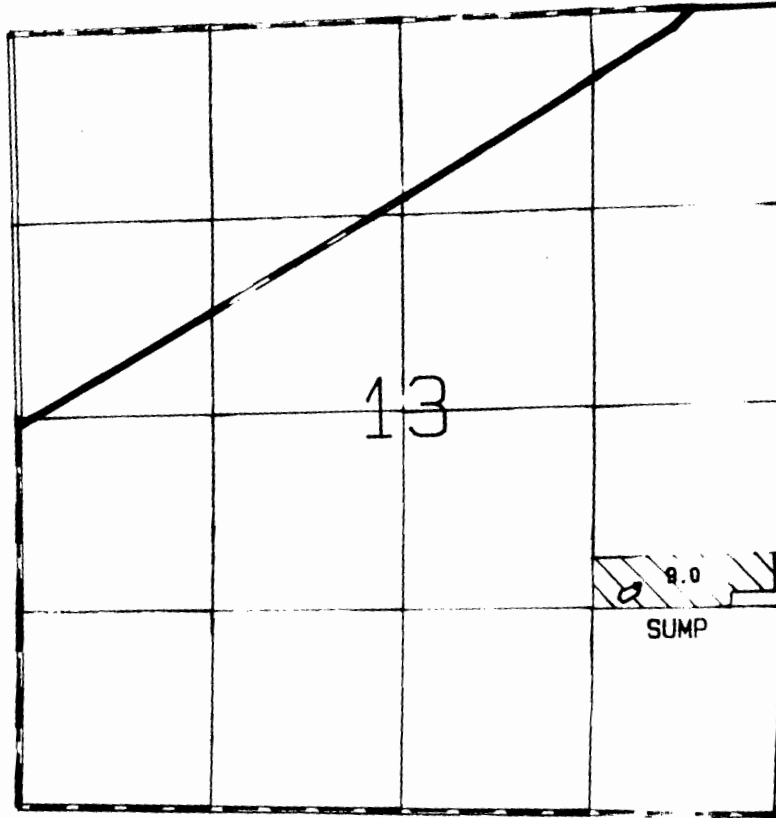

SUMP LOCATED 1520 FT. N & 950 FT. W. FROM SE COR. SEC. 13

SCALE: 1 = 1320

FINAL PROOF SURVEY
UNDER
APPLICATION 6-10548 PERMIT 6-9699
IN NAME OF
CHARLES DRINKWATER
Surveyed Oct. 16, 1987 By M. J. MATTICK

Photo: CHZ 38K-106 LN