


G-9720
58079

T.39 S., R.19 E., W.M.

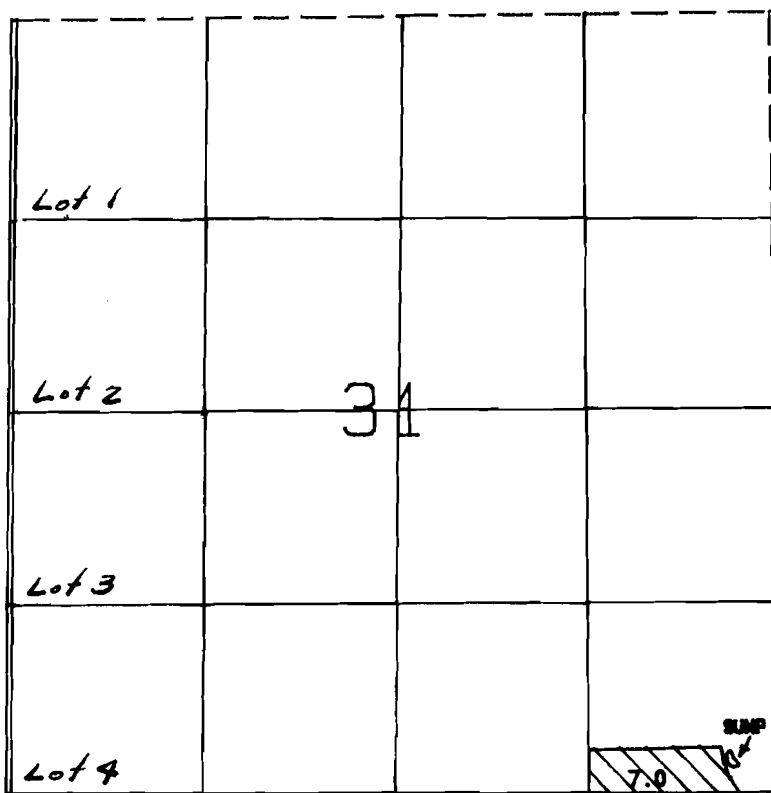

SUMP LOCATED 240 FT. N. AND 330 FT. W. FROM SE COR. SEC. 31

SCALE: 1" = 1320'

FINAL PROOF SURVEY
UNDER

Application No. G-10600 Permit No. G-9720

IN NAME OF

JIM STEWART

Surveyed OCT. 17, 1987 BY T.W. WARREN

Photo: 41037-378-82R RMK/LN