


T. 12S., R. 1W., W.M.

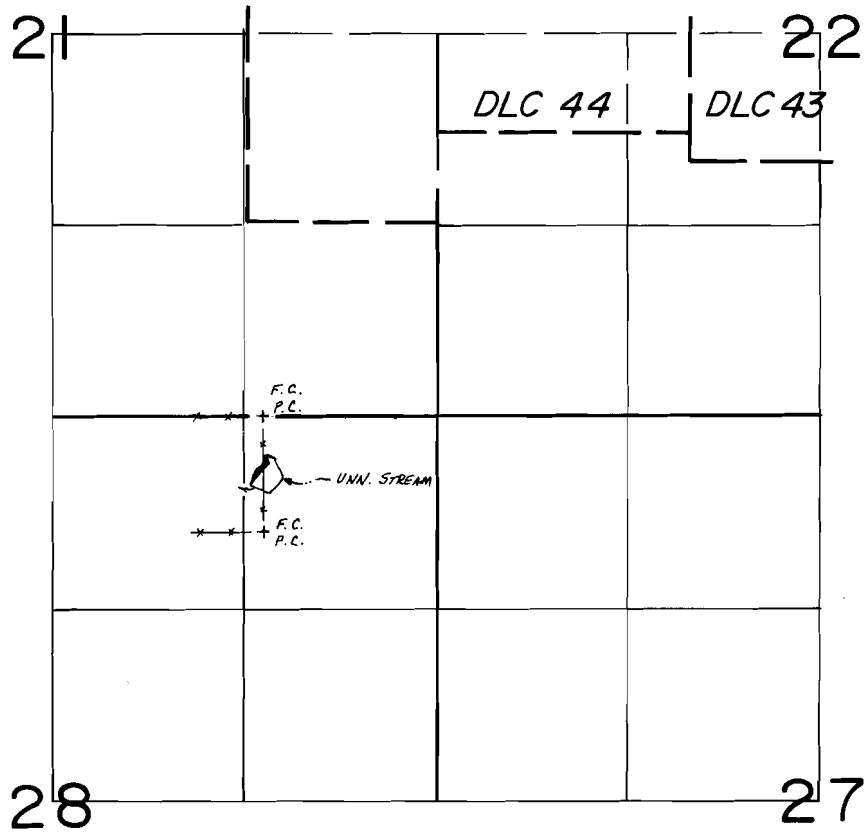

FINAL PROOF SURVEY
UNDER

Application No. R-52534 Permit No. R-6352.....

IN NAME OF

CLAUDE F. BRESHEARS, JR. & EVERETT STATTON

Surveyed MAY 24, 1982, by L. M. TOLL.....