


# T. 3 S., R. 40 E., W. M.

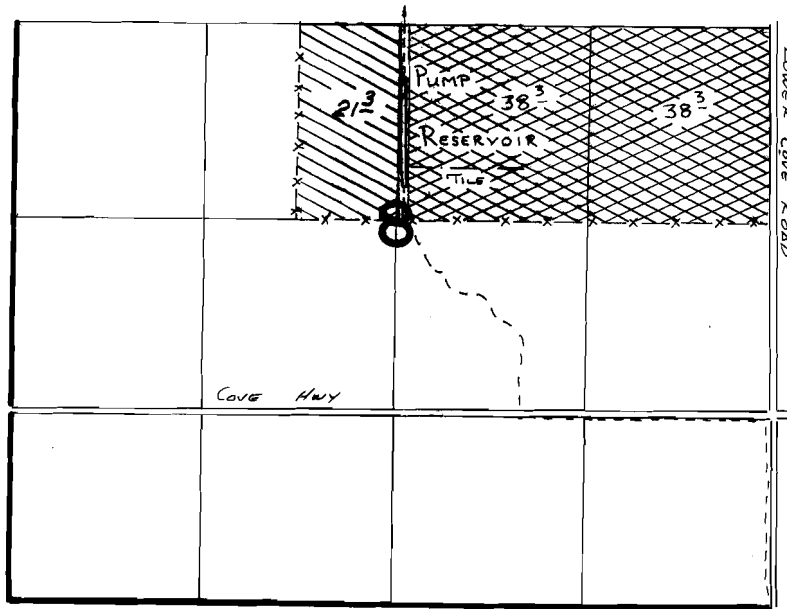

Div. Pt. Loc: 970' N. & 40' E FROM CENTER COR. SEC 8




PER. 48252



PER. 42601



SCALE 1" = 1320'

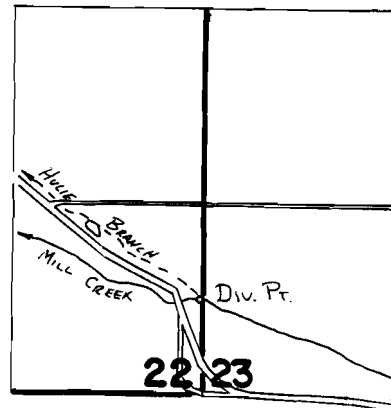

Div. Pt. Loc: 650' N. & 20' W.  
FROM SE COR. SEC. 22

## FINAL PROOF SURVEY

UNDER

56776

42601

R-56775

R-6755

Application No. 67988 Permit No. 48252

IN NAME OF

**RUDOLPH & MARY B. MICHEL**

Surveyed 4-7 1987, by V.L. Church