T. 1S., R. 39E., W.M.

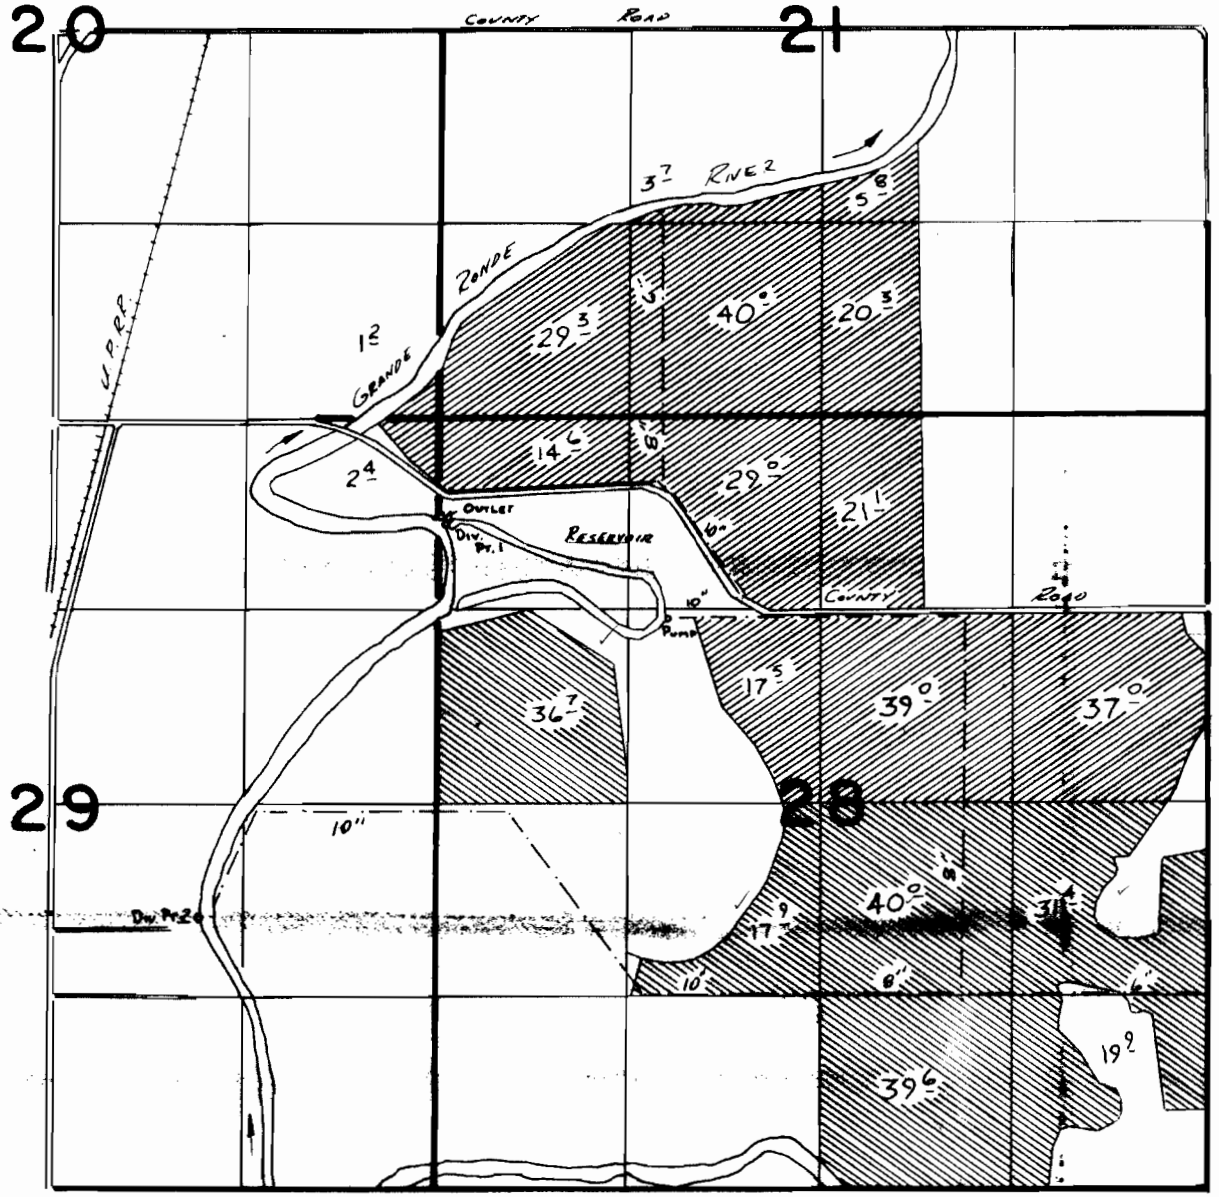

Div. Pt. 1 Loc: 720'S. & 50'E. From NW Cor. Sec 28
Div. Pt. 2 Loc: 1850'N. & 1630'W. From SE Cor. Sec 29
Pump Loc: 1380'S. & 1600'E From NW Cor. Sec 28

FINAL PROOF SURVEY

UNDER

58785	44320
58786	44321
R-58787	

Application No. R-58787 Permit No. R-7844

IN NAME OF

WILLIAM & FLORENCE HOWELL

Surveyed Aug. 23 19 83., by D. L. Church

44321

44320

271R 9/8/83