


T. IS., R. 39E., W.M.

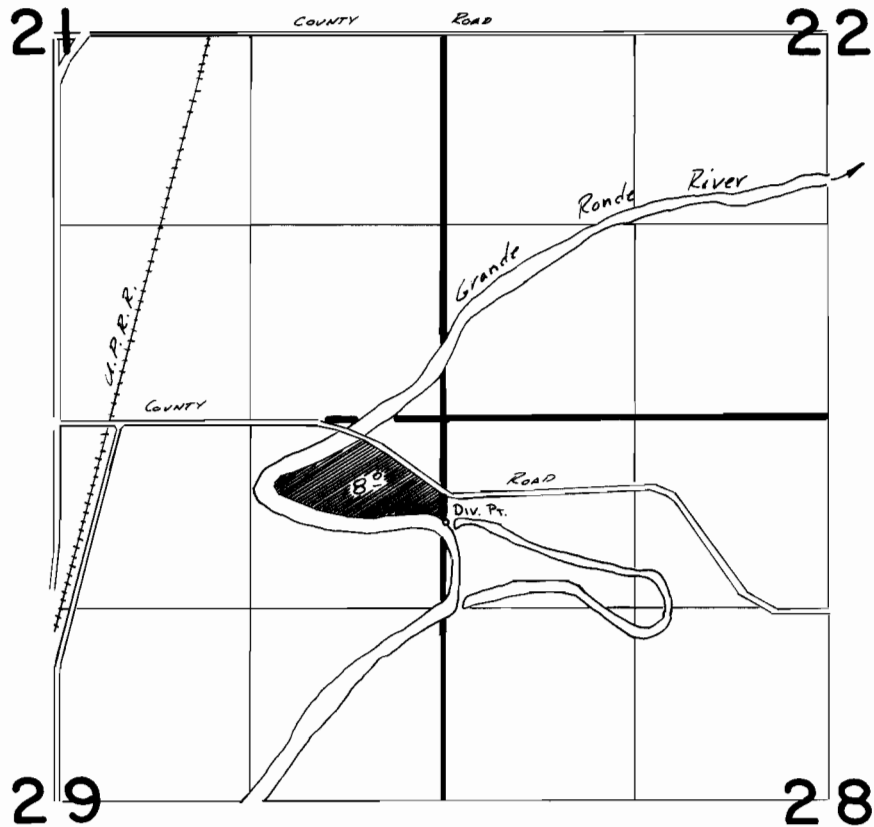

Div. Pt. Loc: 720'S + 50'E. From NW COR. Sec 28

FINAL PROOF SURVEY
UNDER

Application No. **58788** Permit No. **44322**...
IN NAME OF

WILLIAM & FLORENCE HOWELL

Surveyed Aug. 23, 1983, by *V.L. Church*.....