


T.6S.,R.6W.,W.M.

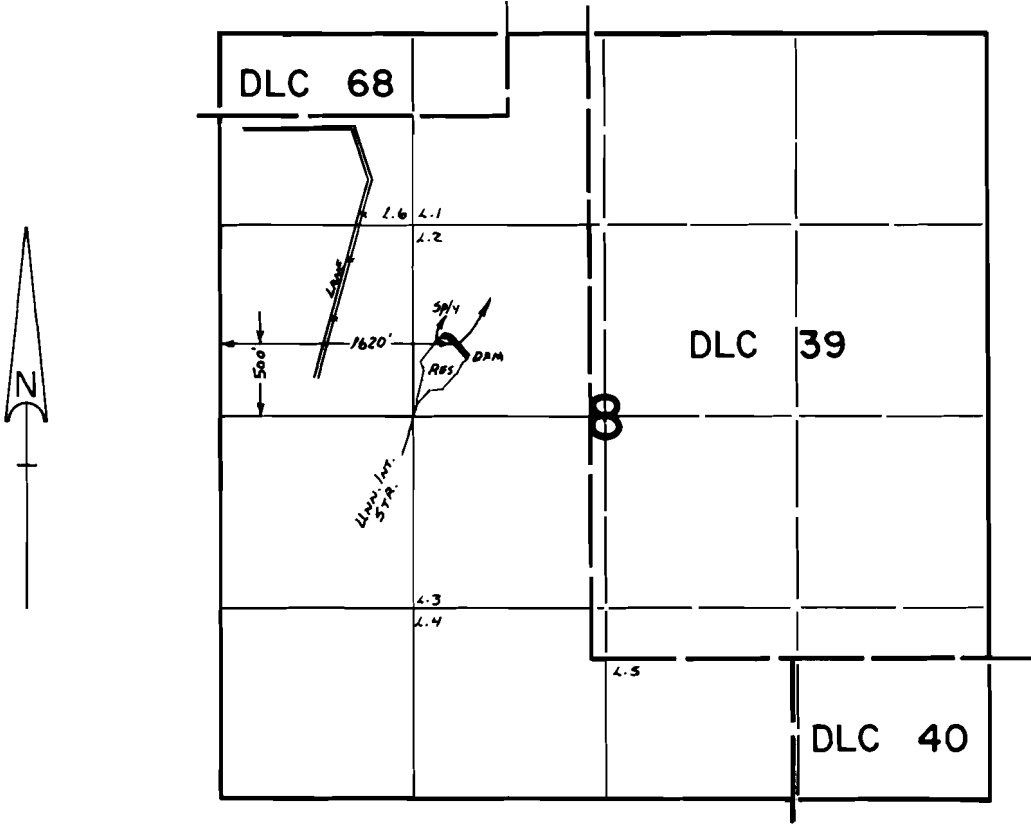

SCALE : 1" = 1320'

**FINAL PROOF SURVEY**  
UNDER

Application No. R-58940 Permit No. R-8112.....  
IN NAME OF

.....**ROBERT GILL**.....

Surveyed Aug...3... 19.83., by ..L..M..TOLL.....