


RECEIVED

SEP 1 1978

WATER RESOURCES DEPT
Salem, Oregon

Application No. *R-59293 + 59294*
Permit No. *R 8132 44869*
T.6 S. R. 4W.W.M.

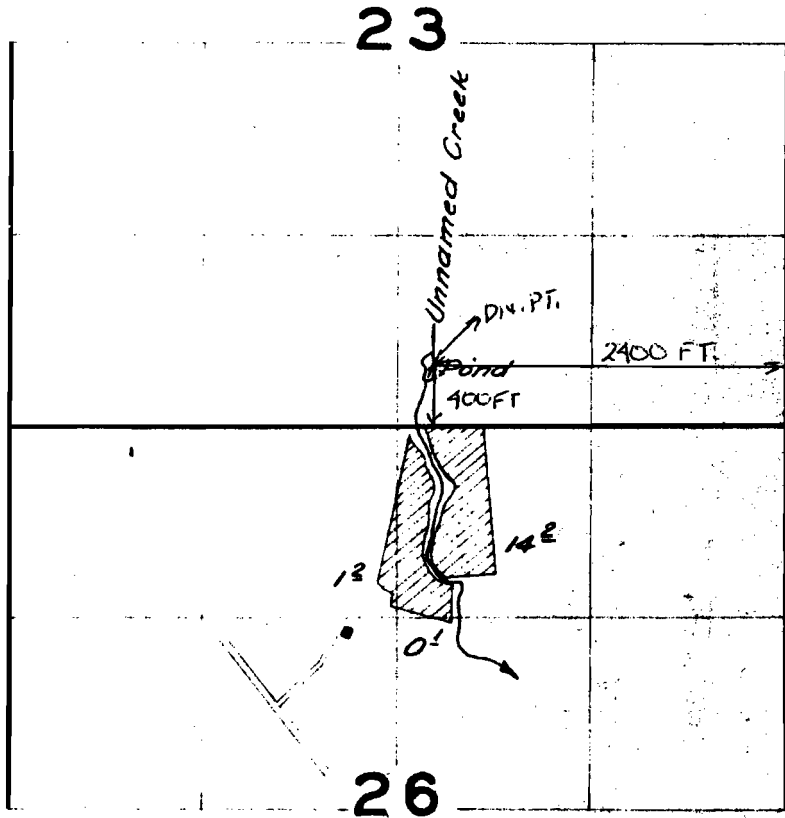

FINAL PROOF SURVEY
UNDER

~~Application No. 29292 Permit No. 23026~~
IN NAME OF

NORMAN L. RICE

Surveyed *June 20, 1960*, by *C. O. Baskin*