


# T.6S.,R.5W.,W.M.

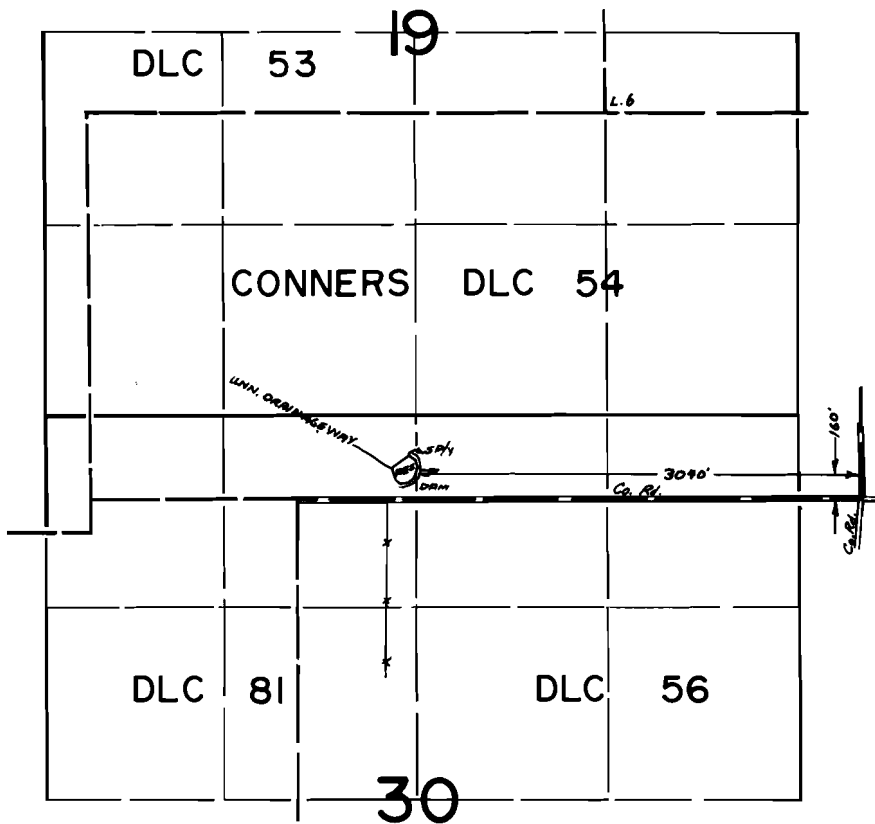

## FINAL PROOF SURVEY UNDER

R-60474                      R-8173  
 Application No. 60475 Permit No. 45037.....

IN NAME OF  
**HOLEMAN L. CONNER &  
 LEOTA BAKER**

Surveyed Nov. 12, 1981, by L. TOLL.....