


# T.6S.,R.5W.,W.M.

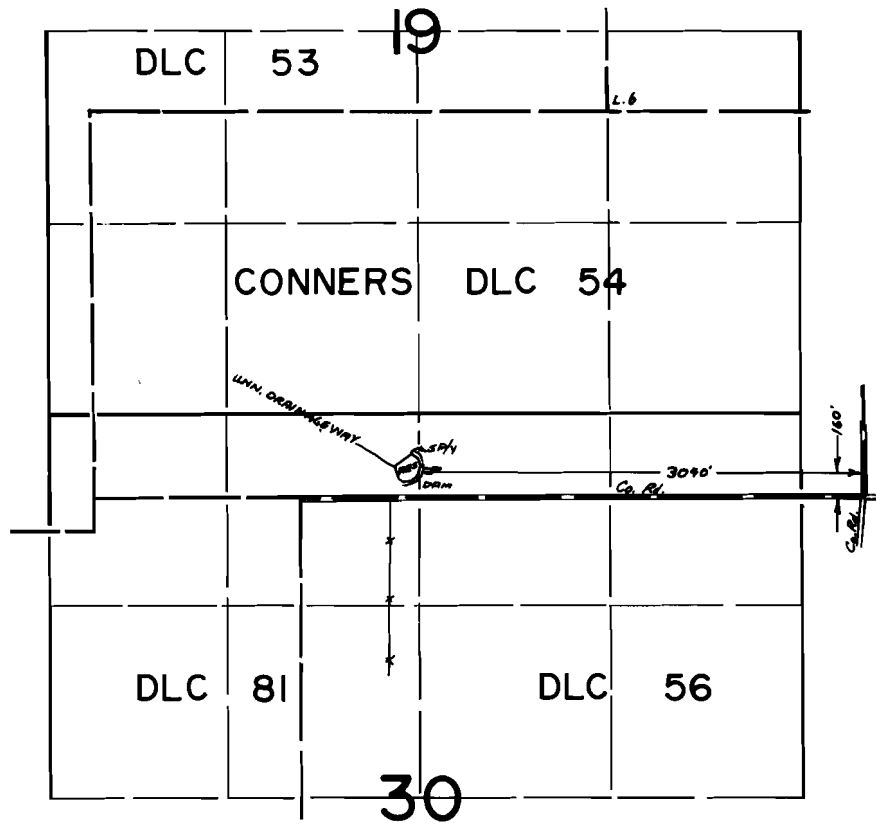

## FINAL PROOF SURVEY UNDER

R-60474                      R-8173  
Application No. 50475      Permit No. 45037.....

IN NAME OF  
HOLEMAN L. CONNER &  
LEOTA BAKER.....

Surveyed Nov...12.. 1981., by ...L.TOLL.....