


T.3S.,R.12E.,WM.

DECEMBER 1978
WATER RESOURCES DIVISION

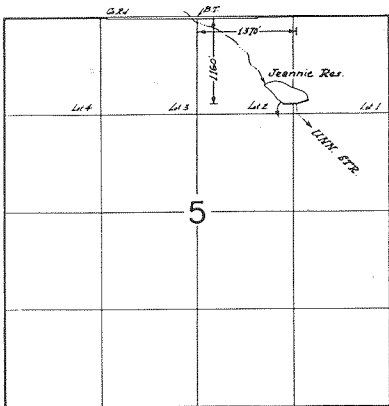

Application No. 61008 E. R. 59459
Permit No. 45436 R 8219

FINAL PROOF SURVEY
UNDER

~~P. 53851 P. 6448~~

~~1978-1979~~ Permit No. ~~153-154~~
IN NAME OF

ORE. DEPT. of FISH & WILDLIFE

Surveyed April 27 1978, by *alt. Applegate*